


P23012 Wingates Plot 3

Drawing Register: Concast


*Please note: All drawings listed below are hyperlinked to the drawings listed.
Please click on the drawing title to go directly to the drawing of your choice.*

**Works Completed: Precast Concrete Walls,
Stairs & Lift Shaft**


Drawing No.	Drawing Title	Rev
P23012-CON-XX-XX-DR-X-0301	Service-Yard-Walls-Plan-&-Sections	AB
P23012-CON-XX-XX-DR-X-0310	Leveller - Sections-And-Details	AB
P23012-CON-XX-XX-DR-X-0311	Dock-Leveller-Plan-And-Elevations	AB
P23012-CON-XX-XX-DR-X-0370	Stair-GA	AB
P23012-CON-XX-XX-DR-X-0380	Lift-Core-General-Arrangement	AB

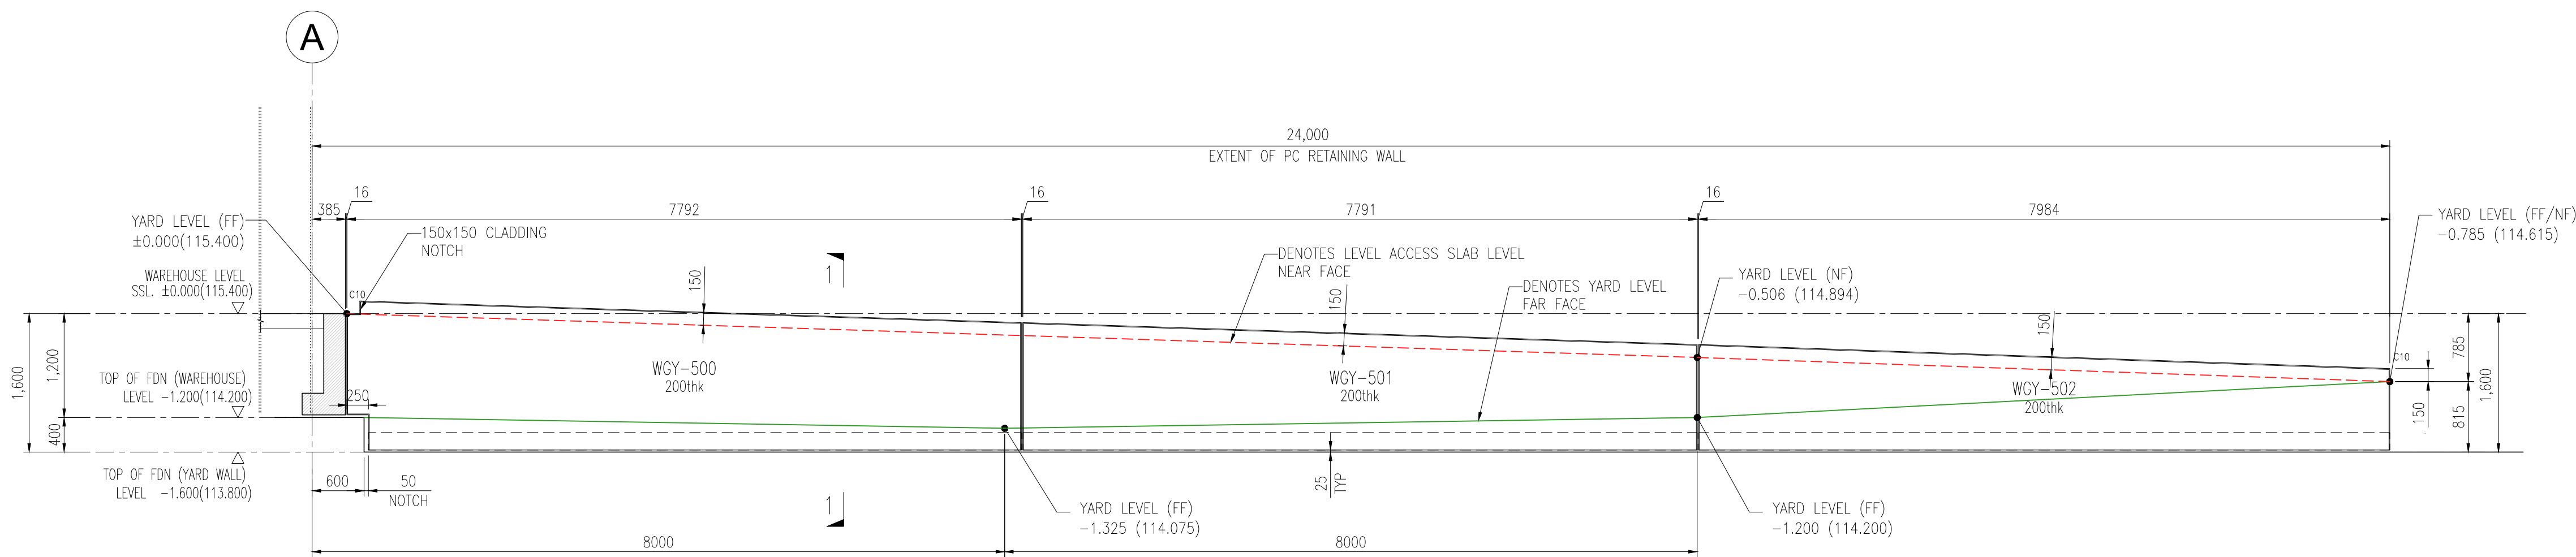


ELEVATION - SERVICE YARD RETAINING WALL @ GRID A 7
SCALE 1:50

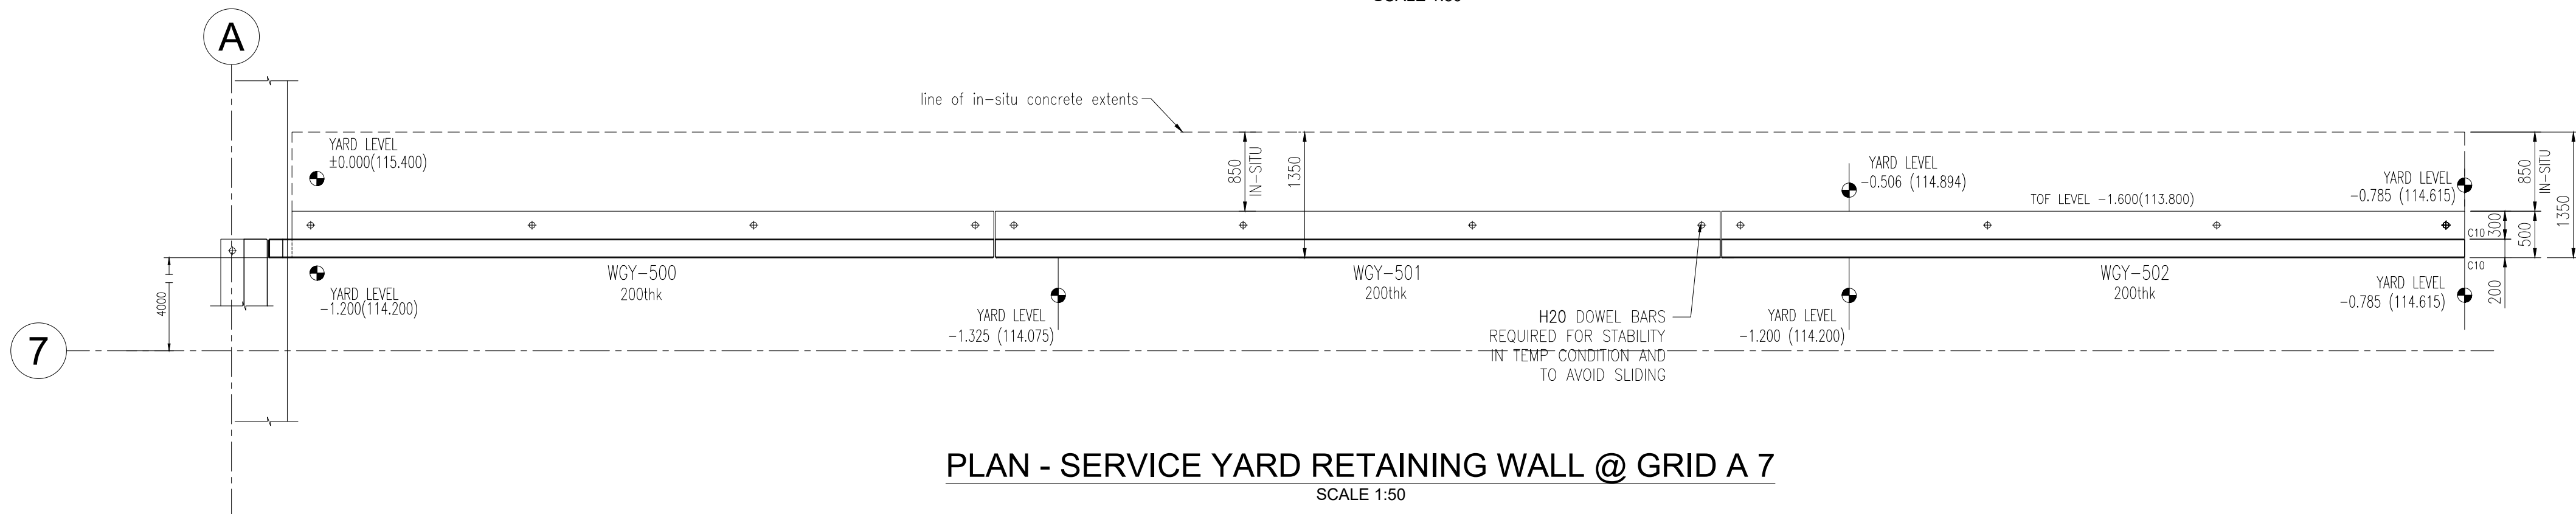


PLAN - SERVICE YARD RETAINING WALL @ GRID A 7
SCALE 1:50

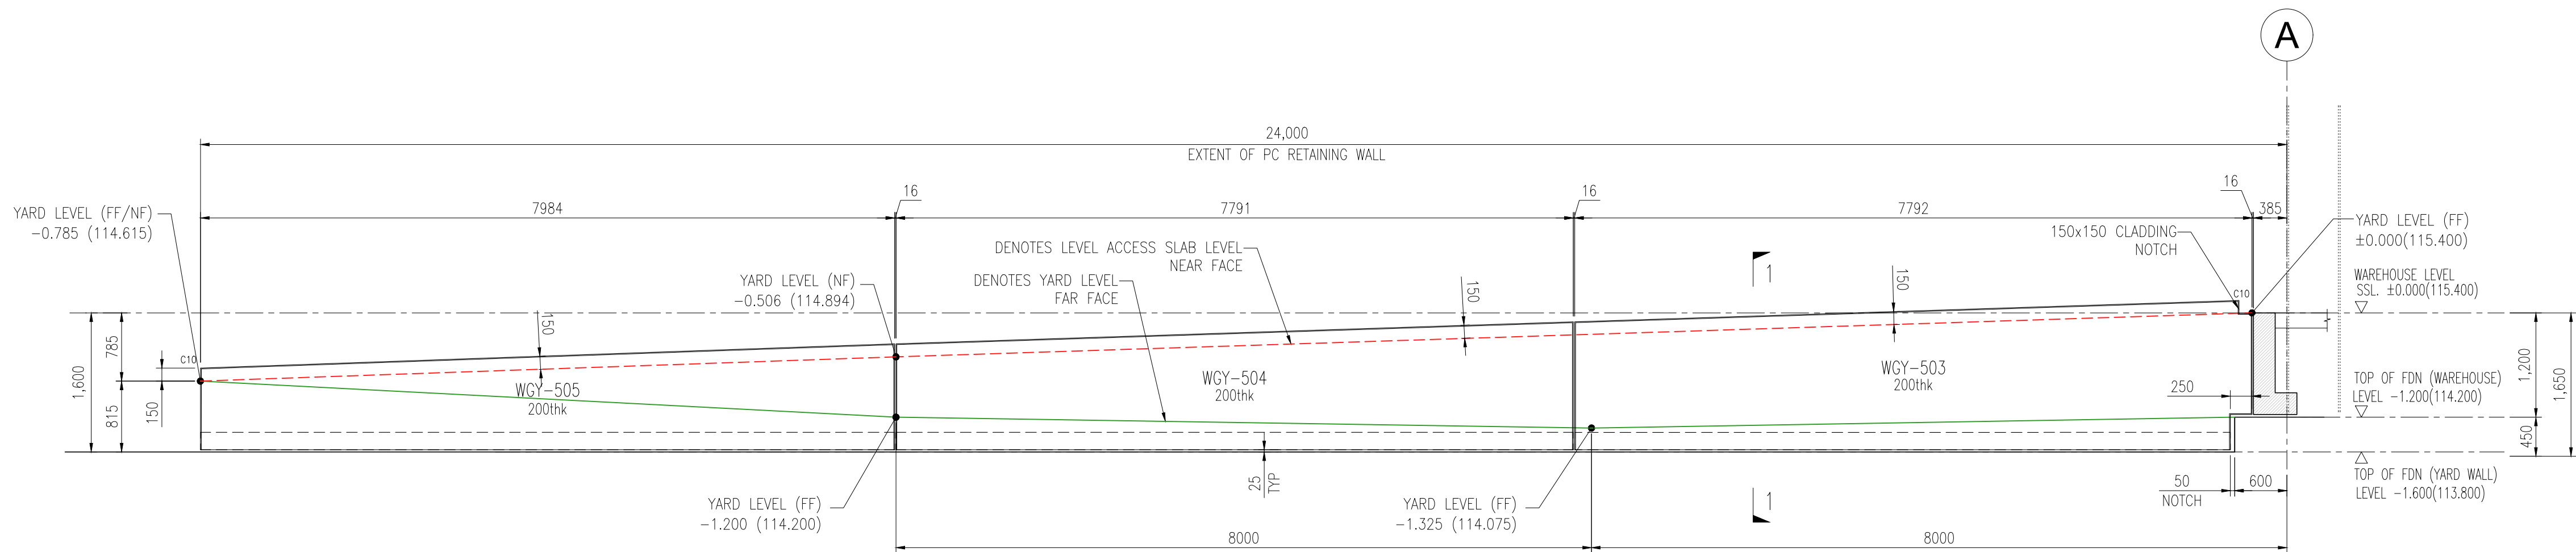

ELEVATION - SERVICE YARD RETAINING WALL @ GRID A 6
SCALE 1:50

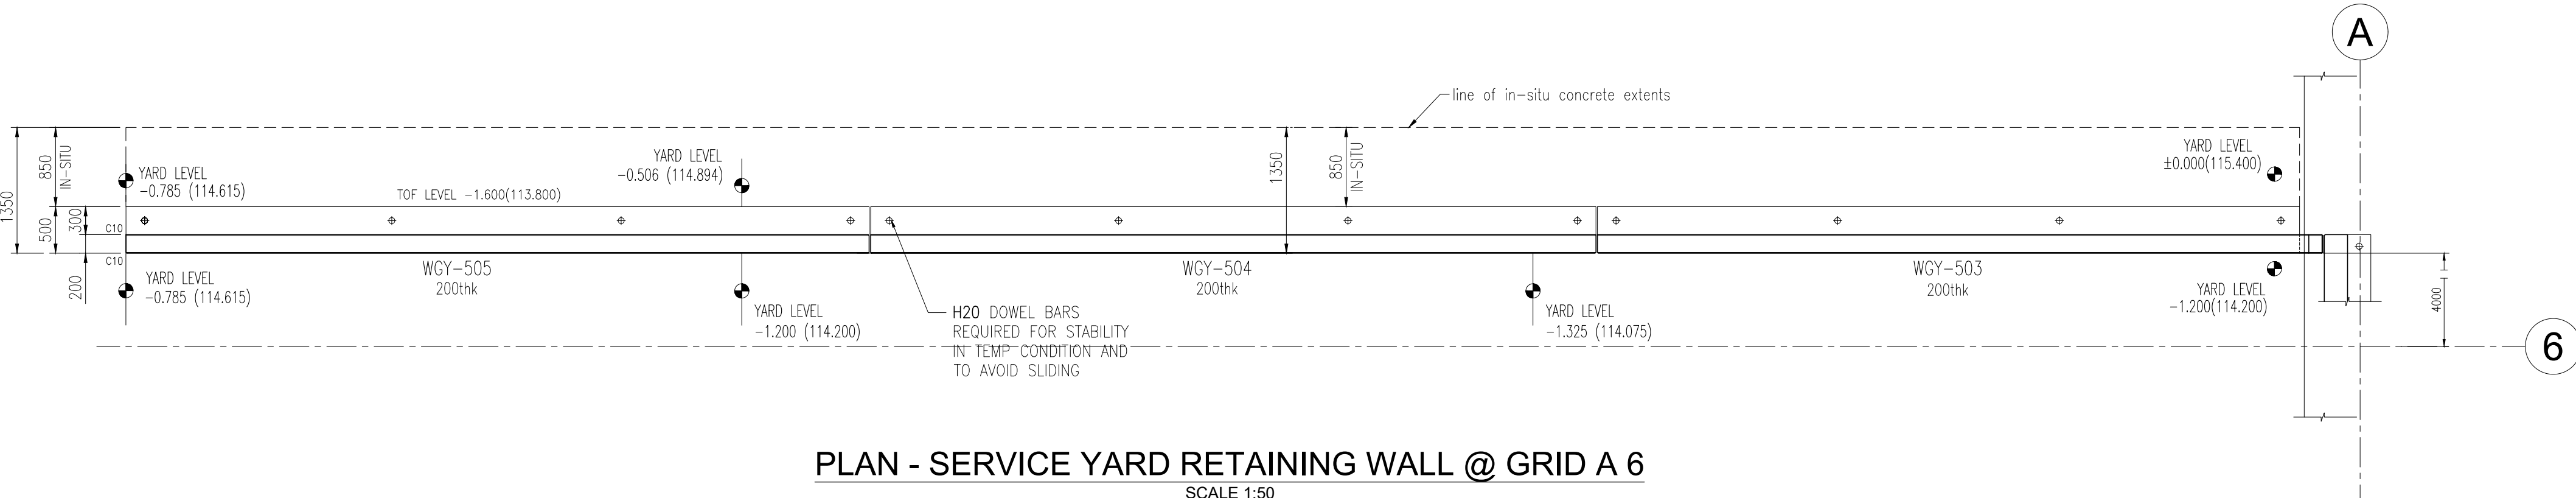

PLAN - SERVICE YARD RETAINING WALL @ GRID A 6
SCALE 1:50

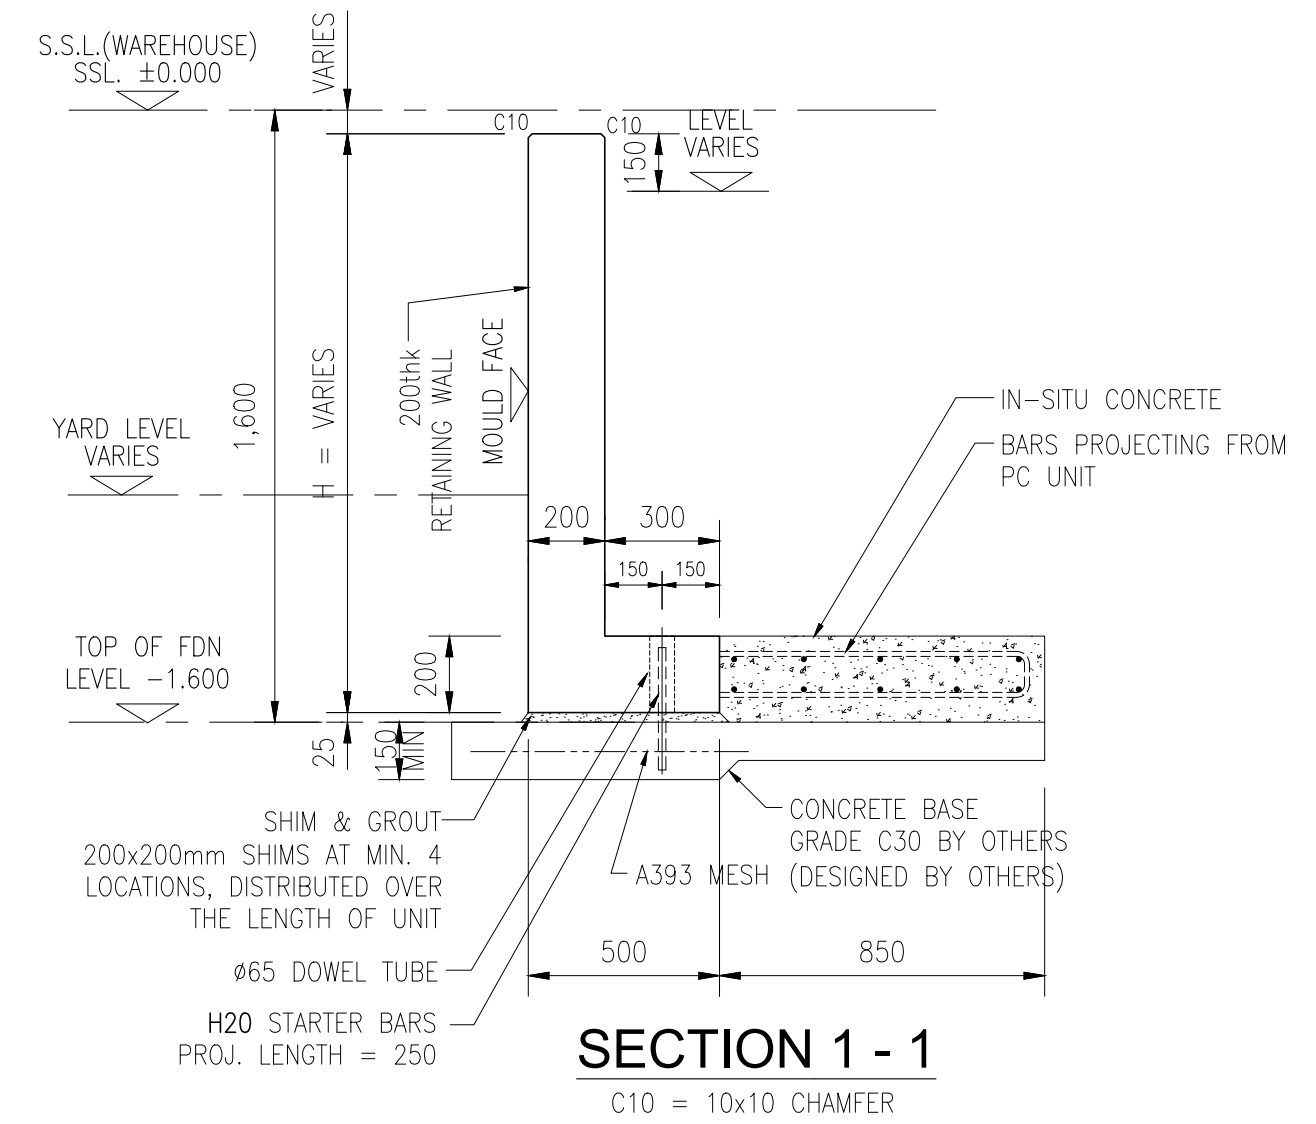

SECTION 1 - 1
C10 = 10x10 CHAMFER

DESIGN NOTES

CONCAST HAVE NO RESPONSIBILITY FOR ANY STRUCTURAL ELEMENTS OTHER THAN THEIR PRECAST MEMBERS. ALL OTHER ELEMENTS SUCH AS NON-PRECAST WALLS (LOADBEARING AND NON-LOADBEARING) AND FOUNDATIONS ARE THE RESPONSIBILITY OF OTHERS.


CONCAST HAVE NO RESPONSIBILITY FOR HOLES CUT IN UNITS UNLESS PERFORMED IN THEIR WORKS OR WRITTEN PERMISSION FOR SAME HAS BEEN OBTAINED.

ALL DRILLING WORKS SHOULD BE DONE ON 150mm. THK. STRUCTURAL LEAF ONLY.

COLUMN CONCRETE ENCASEMENT IF REQUIRED, SHOULD NOT BE POURED PRIOR TO ERECTING PRECAST ELEMENTS

DO NOT SCALE DRAWING, USE FIGURED DIMENSIONS ONLY

C10 = 10X10 CHAMFER NF = NEAR FACE FF = FAR FACE

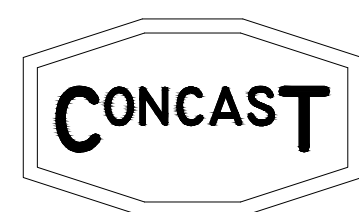

AS BUILT

MAIN CONTRACTOR:

Winvic Construction Ltd

REV	DESCRIPTION	DRAWN	CHECKED	DATE
AB	AS BUILT ISSUE	MS	MQ	13/02/2024
C2	UPDATE TO REMOVE OFFSET FROM DOCK WALL	MS	MQ	01/11/2023
C1	ISSUED FOR CONSTRUCTION	SH	MQ	19/10/2023
P2	DOCKSLAB SIZE CONFIRMED	SH	MQ	05/10/2023
P1	FIRST ISSUE	SH	MQ	27/09/2023

CONCAST
Structural Precast Concrete Contractors
THIS DRAWING AND ANY DESIGN HEREON IS THE PROPERTY OF CONCAST PRECAST LIMITED © AND MUST NOT BE REPRODUCED WITHOUT THEIR WRITTEN CONSENT.

CONCAST
Hazelhatch Road Newcastle Co. Dublin
Tel: (01) 6288055 Fax: (01) 6272326/6288104
Email: info@concastprecast.co.uk

DATE	SEP 2023	JOB No.	2023-935	REV	AB
SCALE	1:50	DRAWING No.	P23012-CON-XX-XX-DR-X-0301		
PROJECT	PLOT 3 WINGATES BOLTON				
TITLE	SERVICE YARD WALLS-PLAN & SECTIONS				



C10: 10x10 CHAMFER

CONCAST HAVE NO RESPONSIBILITY FOR ANY STRUCTURAL ELEMENTS OTHER THAN THEIR PRECAST MEMBERS. ALL OTHER ELEMENTS SUCH AS NON-PRECAST WALLS (LOADBEARING AND NON-LOADBEARING) AND FOUNDATIONS ARE THE RESPONSIBILITY OF OTHERS.


CONCAST HAVE NO RESPONSIBILITY FOR HOLES CUT IN UNITS
UNLESS PERFORMED IN THEIR WORKS OR WRITTEN PERMISSION
FOR SAME HAS BEEN OBTAINED.

ALL DRILLING WORKS SHOULD BE DONE ON 150mm. THK. STRUCTURAL LEAF ONLY.

COLUMN CONCRETE ENCASEMENT IF REQUIRED, SHOULD NOT BE
POURED PRIOR TO ERECTING PRECAST ELEMENTS

DO NOT SCALE DRAWING, USE FIGURED DIMENSIONS ONLY

C10 = 10X10 CHAMFER NF = NEAR FACE FF = FAR FACE

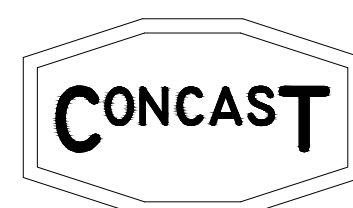

AS BUILT

MAIN CONTRACTOR:

Winvic Construction Ltd

--	--	--	--	--
AB	AS BUILT ISSUE	SH	MS	13/02/2020
C2	DOOR OPENING CONFIRMED	SH	MQ	24/11/2019
C1	ISSUED FOR CONSTRUCTION	SH	MQ	07/11/2019
P2	ISSUED FOR APPROVAL	SH	MQ	26/10/2019
P1	FIRST ISSUE	SH	MQ	03/10/2019
REV	DESCRIPTION	DRAWN	CHECKED	DATE




Structural Precast
Concrete Contractors


Hazelhatch Road Newcastle Co. Dublin
Tel: (01) 6288055 Fax: (01) 6272326/6288104
Email : info@concastprecast.co.uk

THIS DRAWING AND ANY DESIGN HEREON IS THE PROPERTY OF CONCAST PRECAST LIMITED
AND MUST NOT BE REPRODUCED WITHOUT THEIR WRITTEN CONSENT


DATE	SEP 2023	Job No.	2023-935	REV	
SCALE	NTS	DRAWING No.	P23012-CON-XX-XX-DR-X-0310		AB
<u>PROJECT</u>					
PLOT 3 WINGATES BOLTON					
<u>TITLE</u>					
DOCK LEVELLER - SECTIONS AND DETAILS					

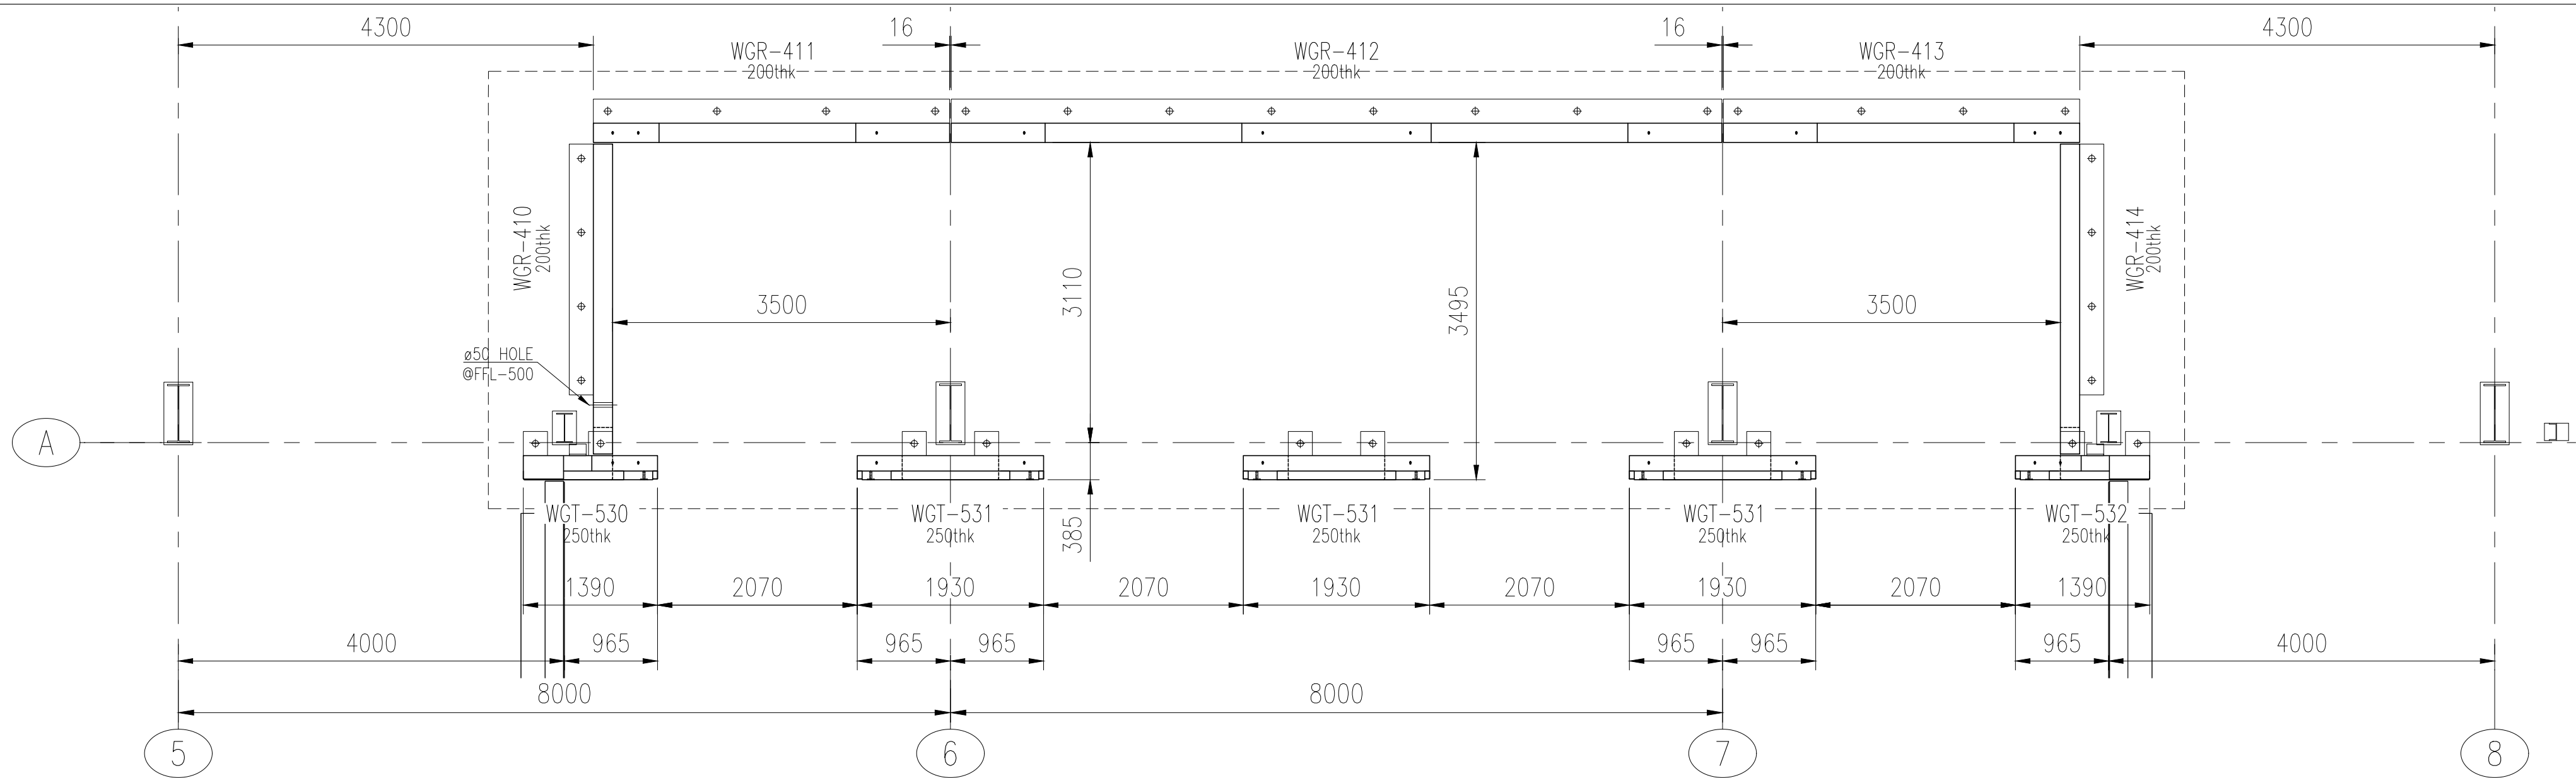

RETAINING WALL PLAN

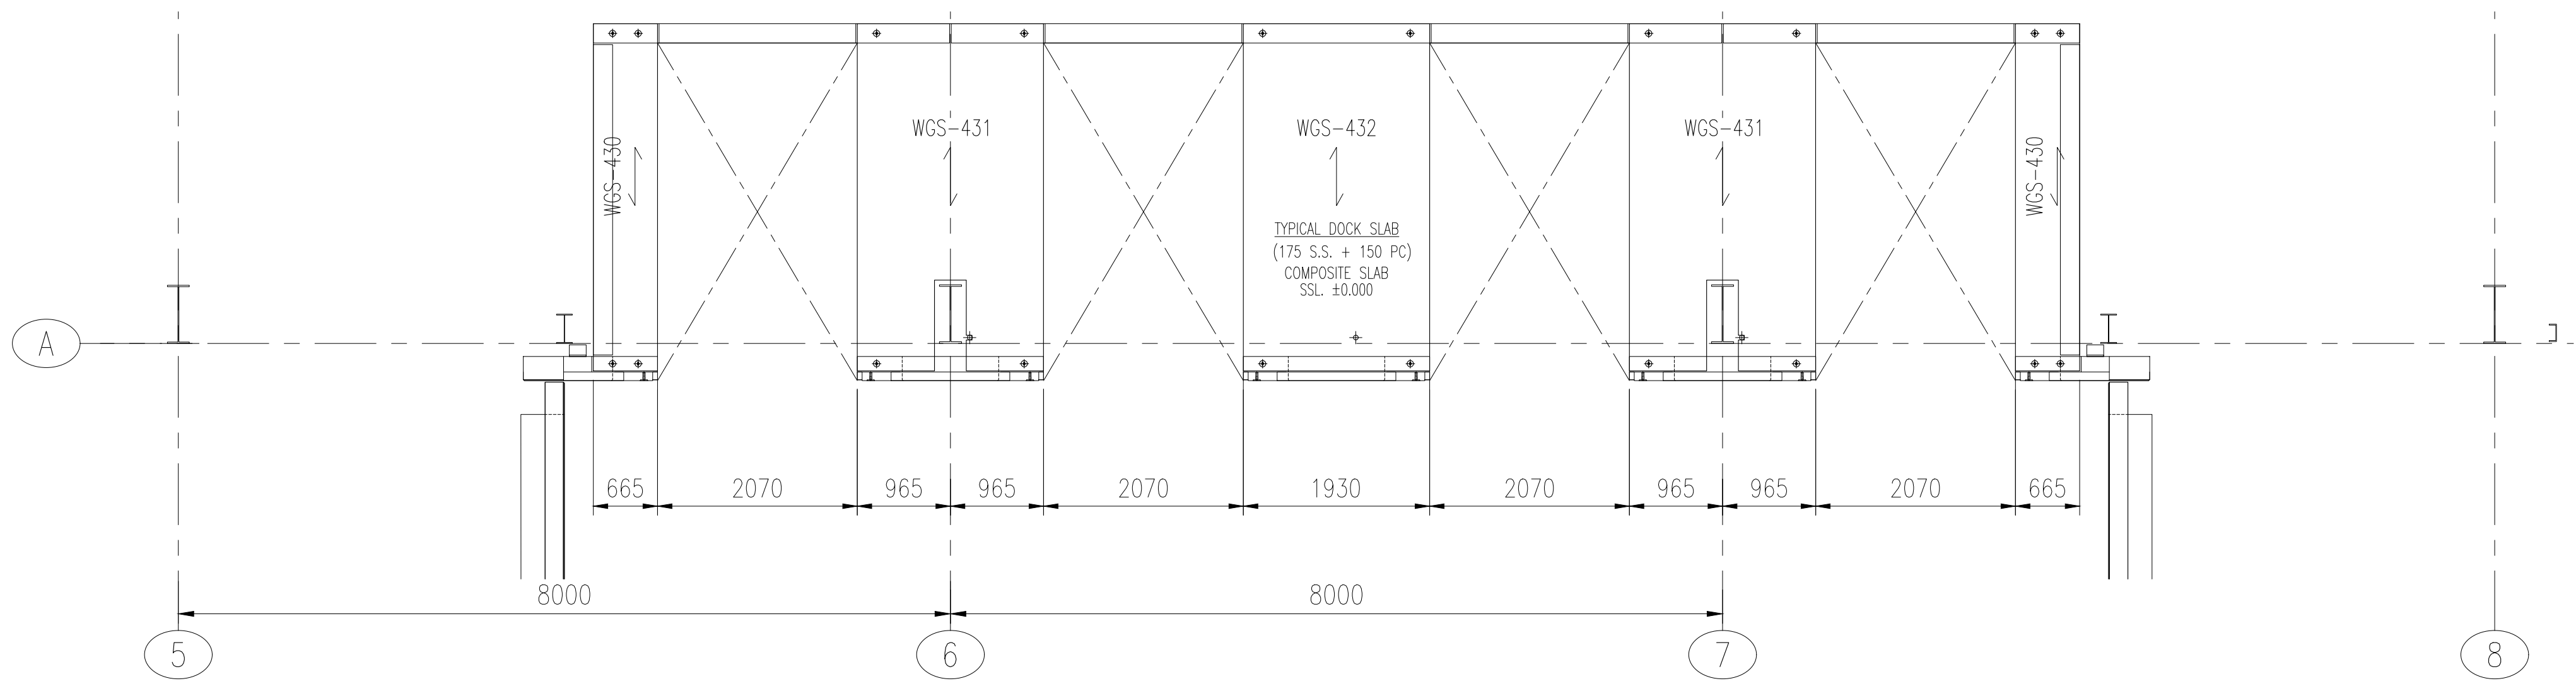

DOCK SLAB PLAN

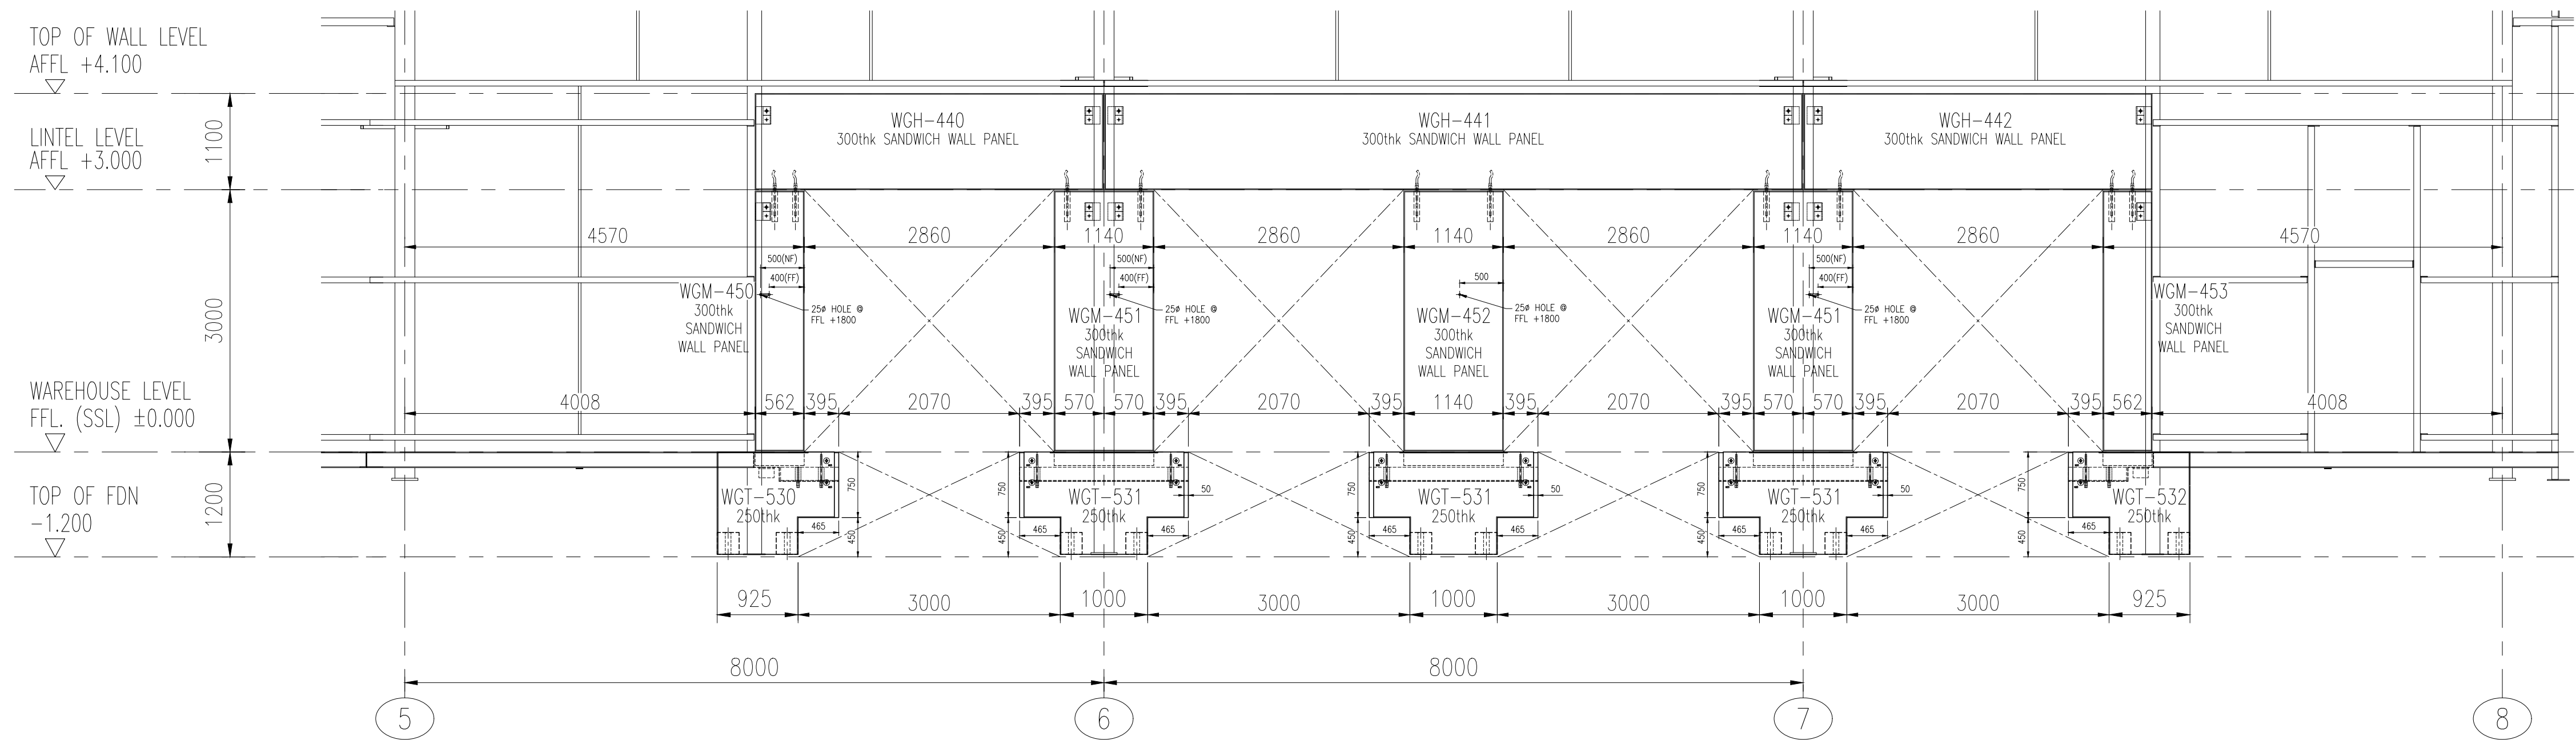

FRONT WALL ELEVATION

DESIGN NOTES

CONCAST HAVE NO RESPONSIBILITY FOR ANY STRUCTURAL ELEMENTS OTHER THAN THEIR PRECAST MEMBERS. ALL OTHER ELEMENTS SUCH AS NON-PRECAST WALLS (LOADBEARING AND NON-LOADBEARING) AND FOUNDATIONS ARE THE RESPONSIBILITY OF OTHERS.


CONCAST HAVE NO RESPONSIBILITY FOR HOLES CUT IN UNITS UNLESS PERFORMED IN THEIR WORKS OR WRITTEN PERMISSION FOR SAME HAS BEEN OBTAINED.

ALL DRILLING WORKS SHOULD BE DONE ON 150mm. THK. STRUCTURAL LEAF ONLY.

COLUMN CONCRETE ENCASEMENT IF REQUIRED, SHOULD NOT BE POURED PRIOR TO ERECTING PRECAST ELEMENTS

DO NOT SCALE DRAWING, USE FIGURED DIMENSIONS ONLY

C10 = 10X10 CHAMFER NF = NEAR FACE FF = FAR FACE

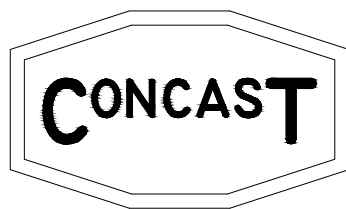

AS BUILT





MAIN CONTRACTOR:
Winvic Construction Ltd

AB	AS BUILT ISSUE	SH	MQ	13/02/2024
C2	DOOR OPENING SIZE CONFIRMED	SH	MQ	24/11/2023
C1	ISSUED FOR CONSTRUCTION	SH	MQ	07/11/2023
P2	UPDATED TO COMMENTS + STEEL/DOCK INFO	SH	MQ	26/10/2023
P1	FIRST ISSUE	SH	MQ	03/10/2023
REV	DESCRIPTION	DRAWN	CHECKED	DATE



CONCAST
Hazelhatch Road Newcastle Co. Dublin
Tel: (01) 6288055 Fax: (01) 6272326/6288104
Email: info@concastprecast.co.uk

DATE	SEP 2023	JOB No.	2023-935	REV	AB
SCALE	1:50	DRAWING No.	P23012-CON-XX-XX-DR-X-0311		
PROJECT	PLOT 3 WINGATES BOLTON				
TITLE	DOCK LEVELLER - PLAN AND ELEVATIONS				

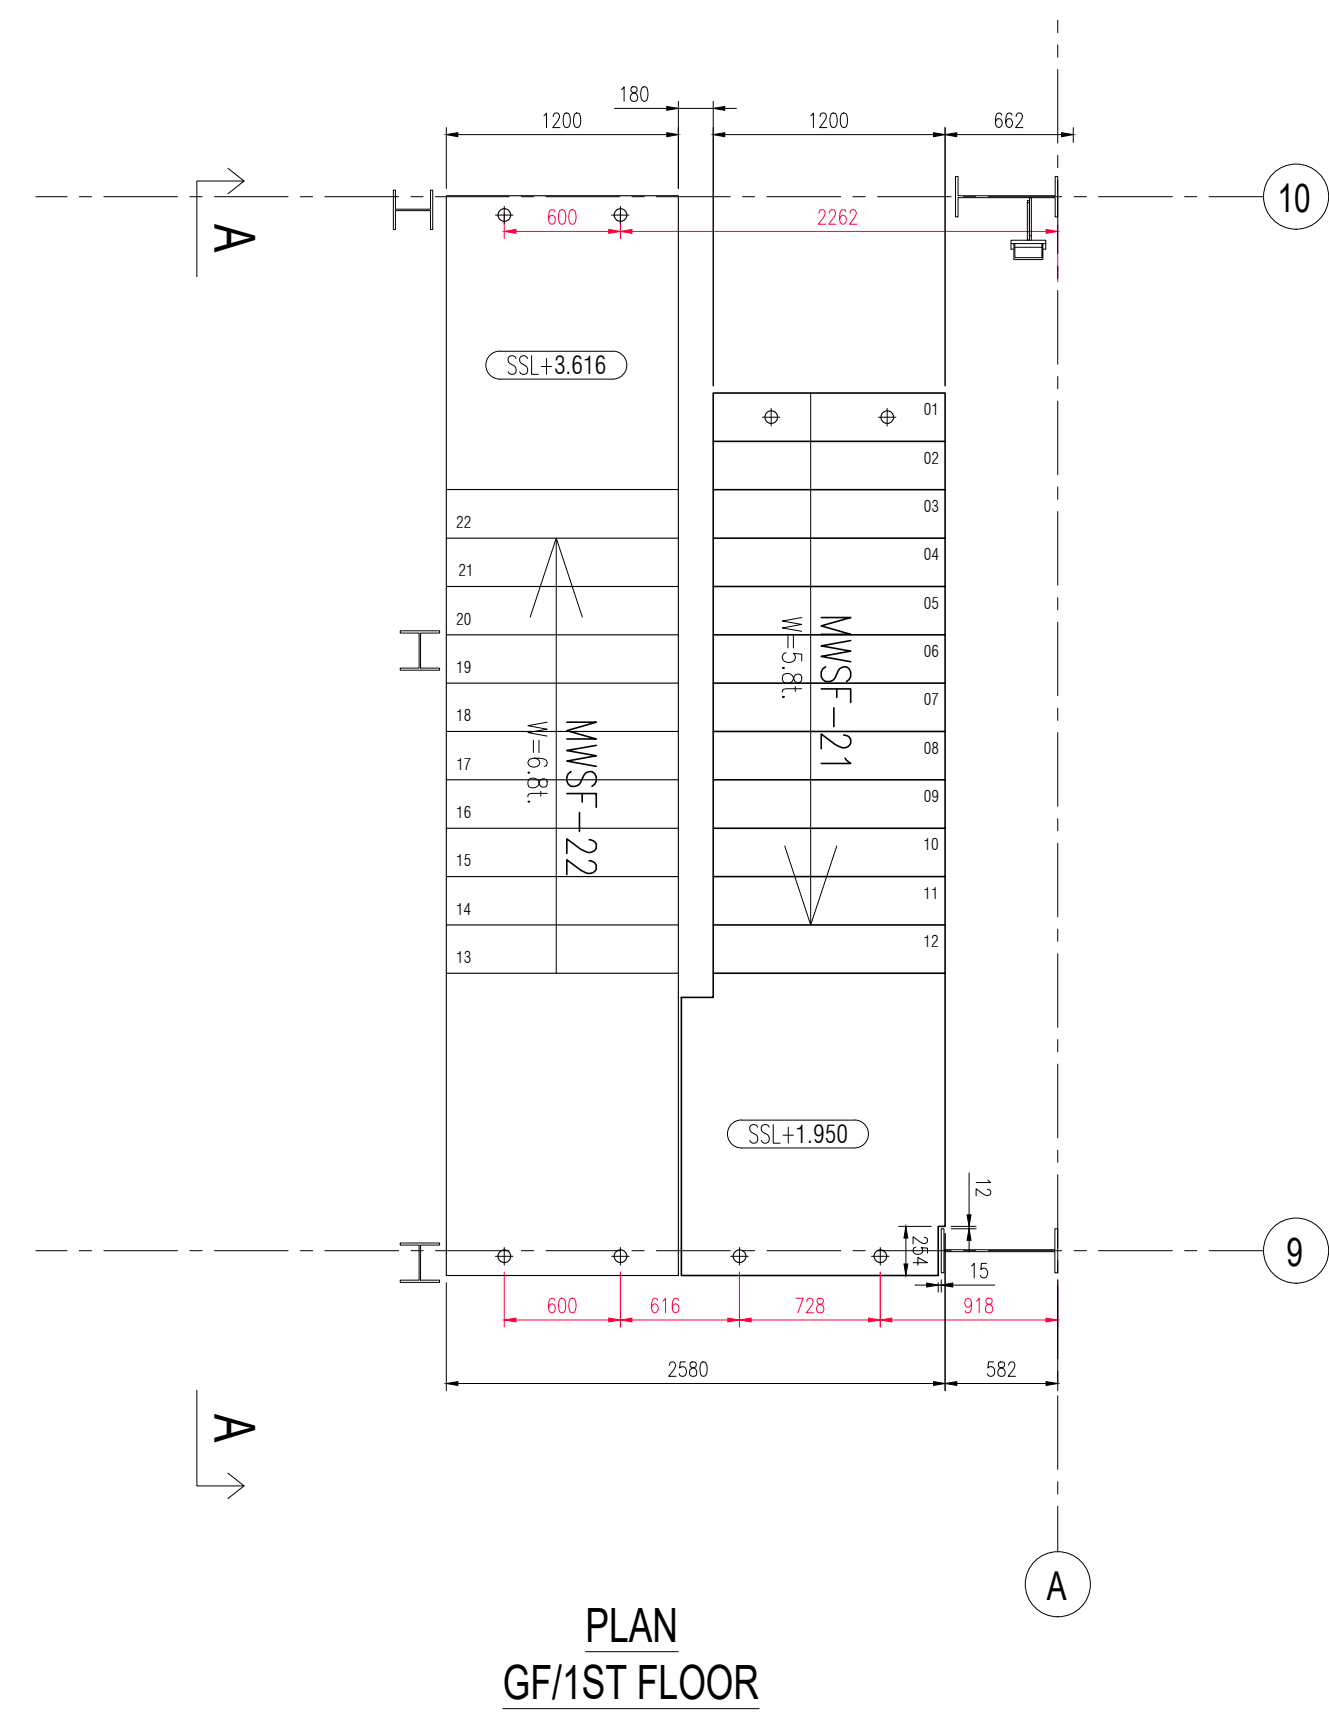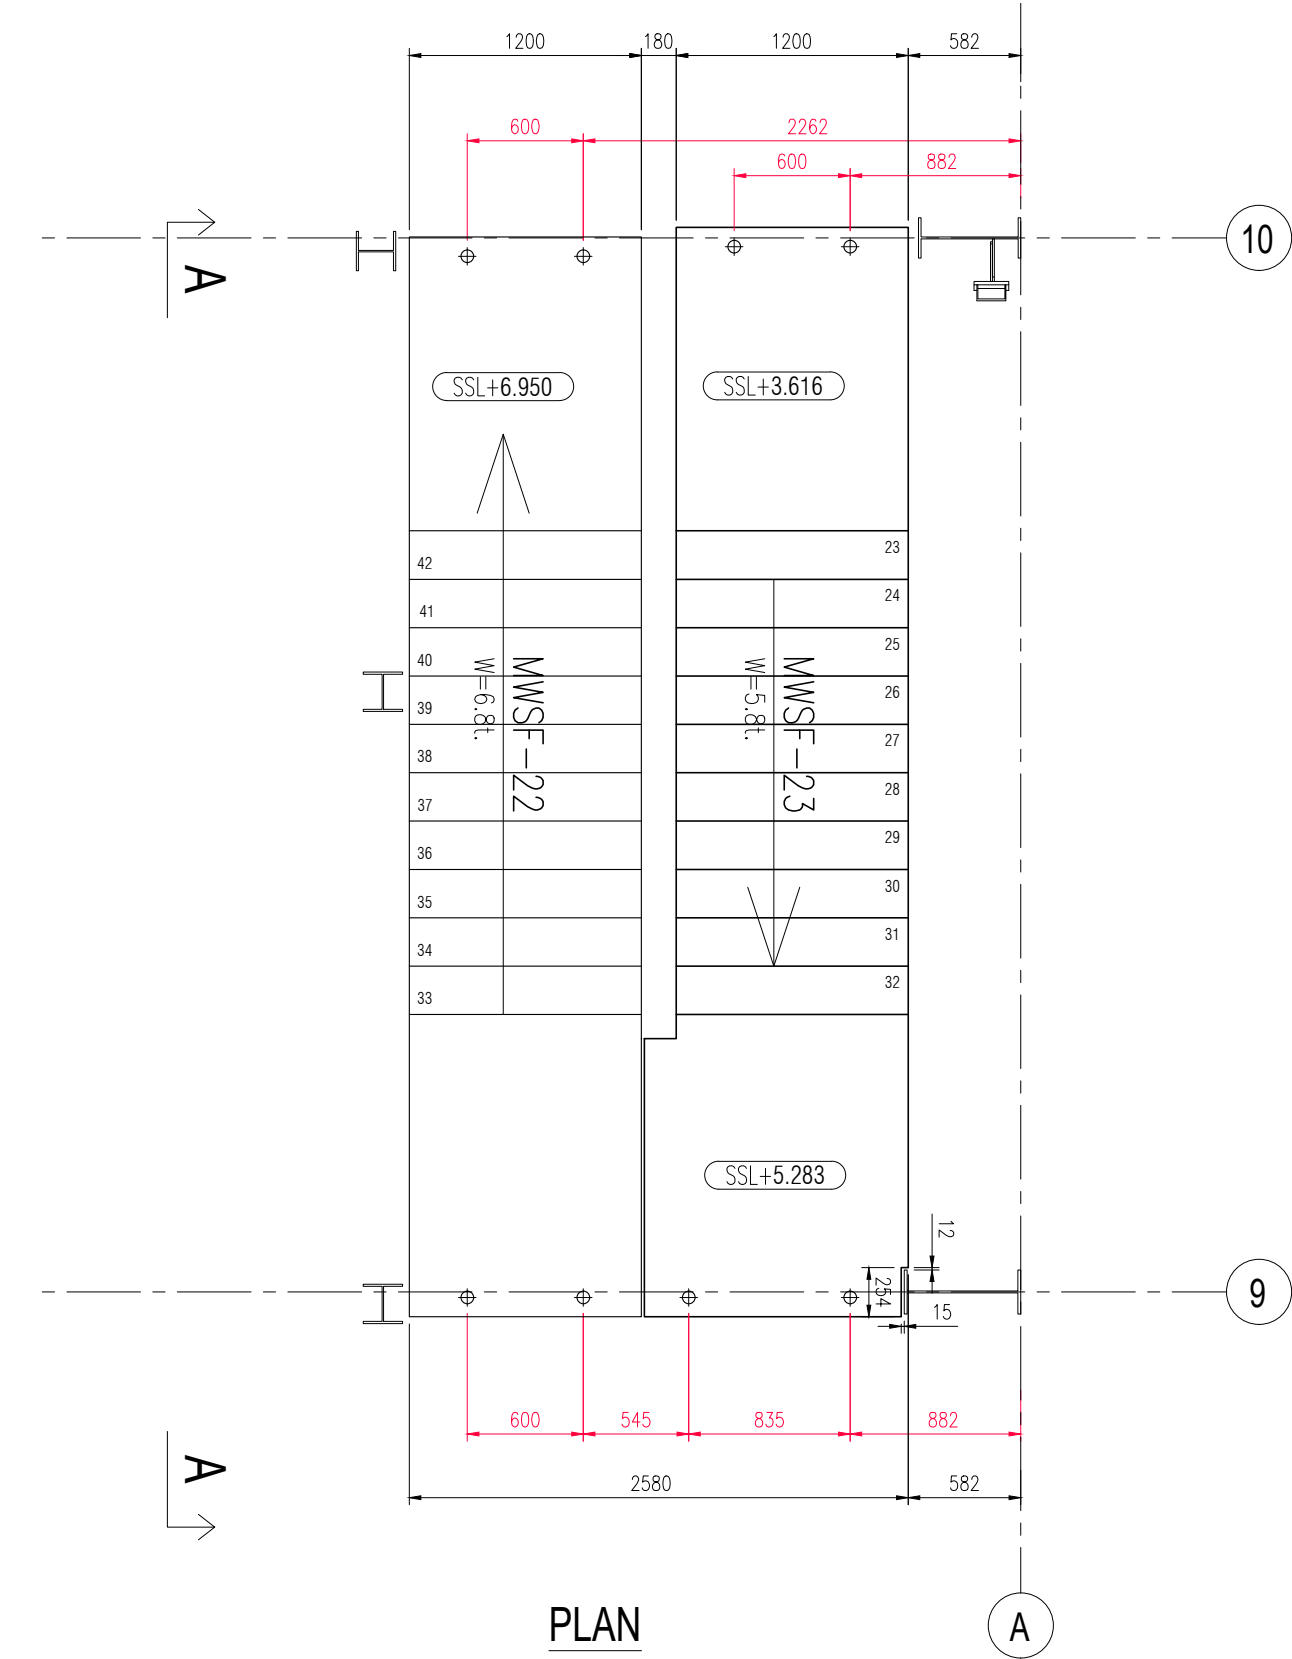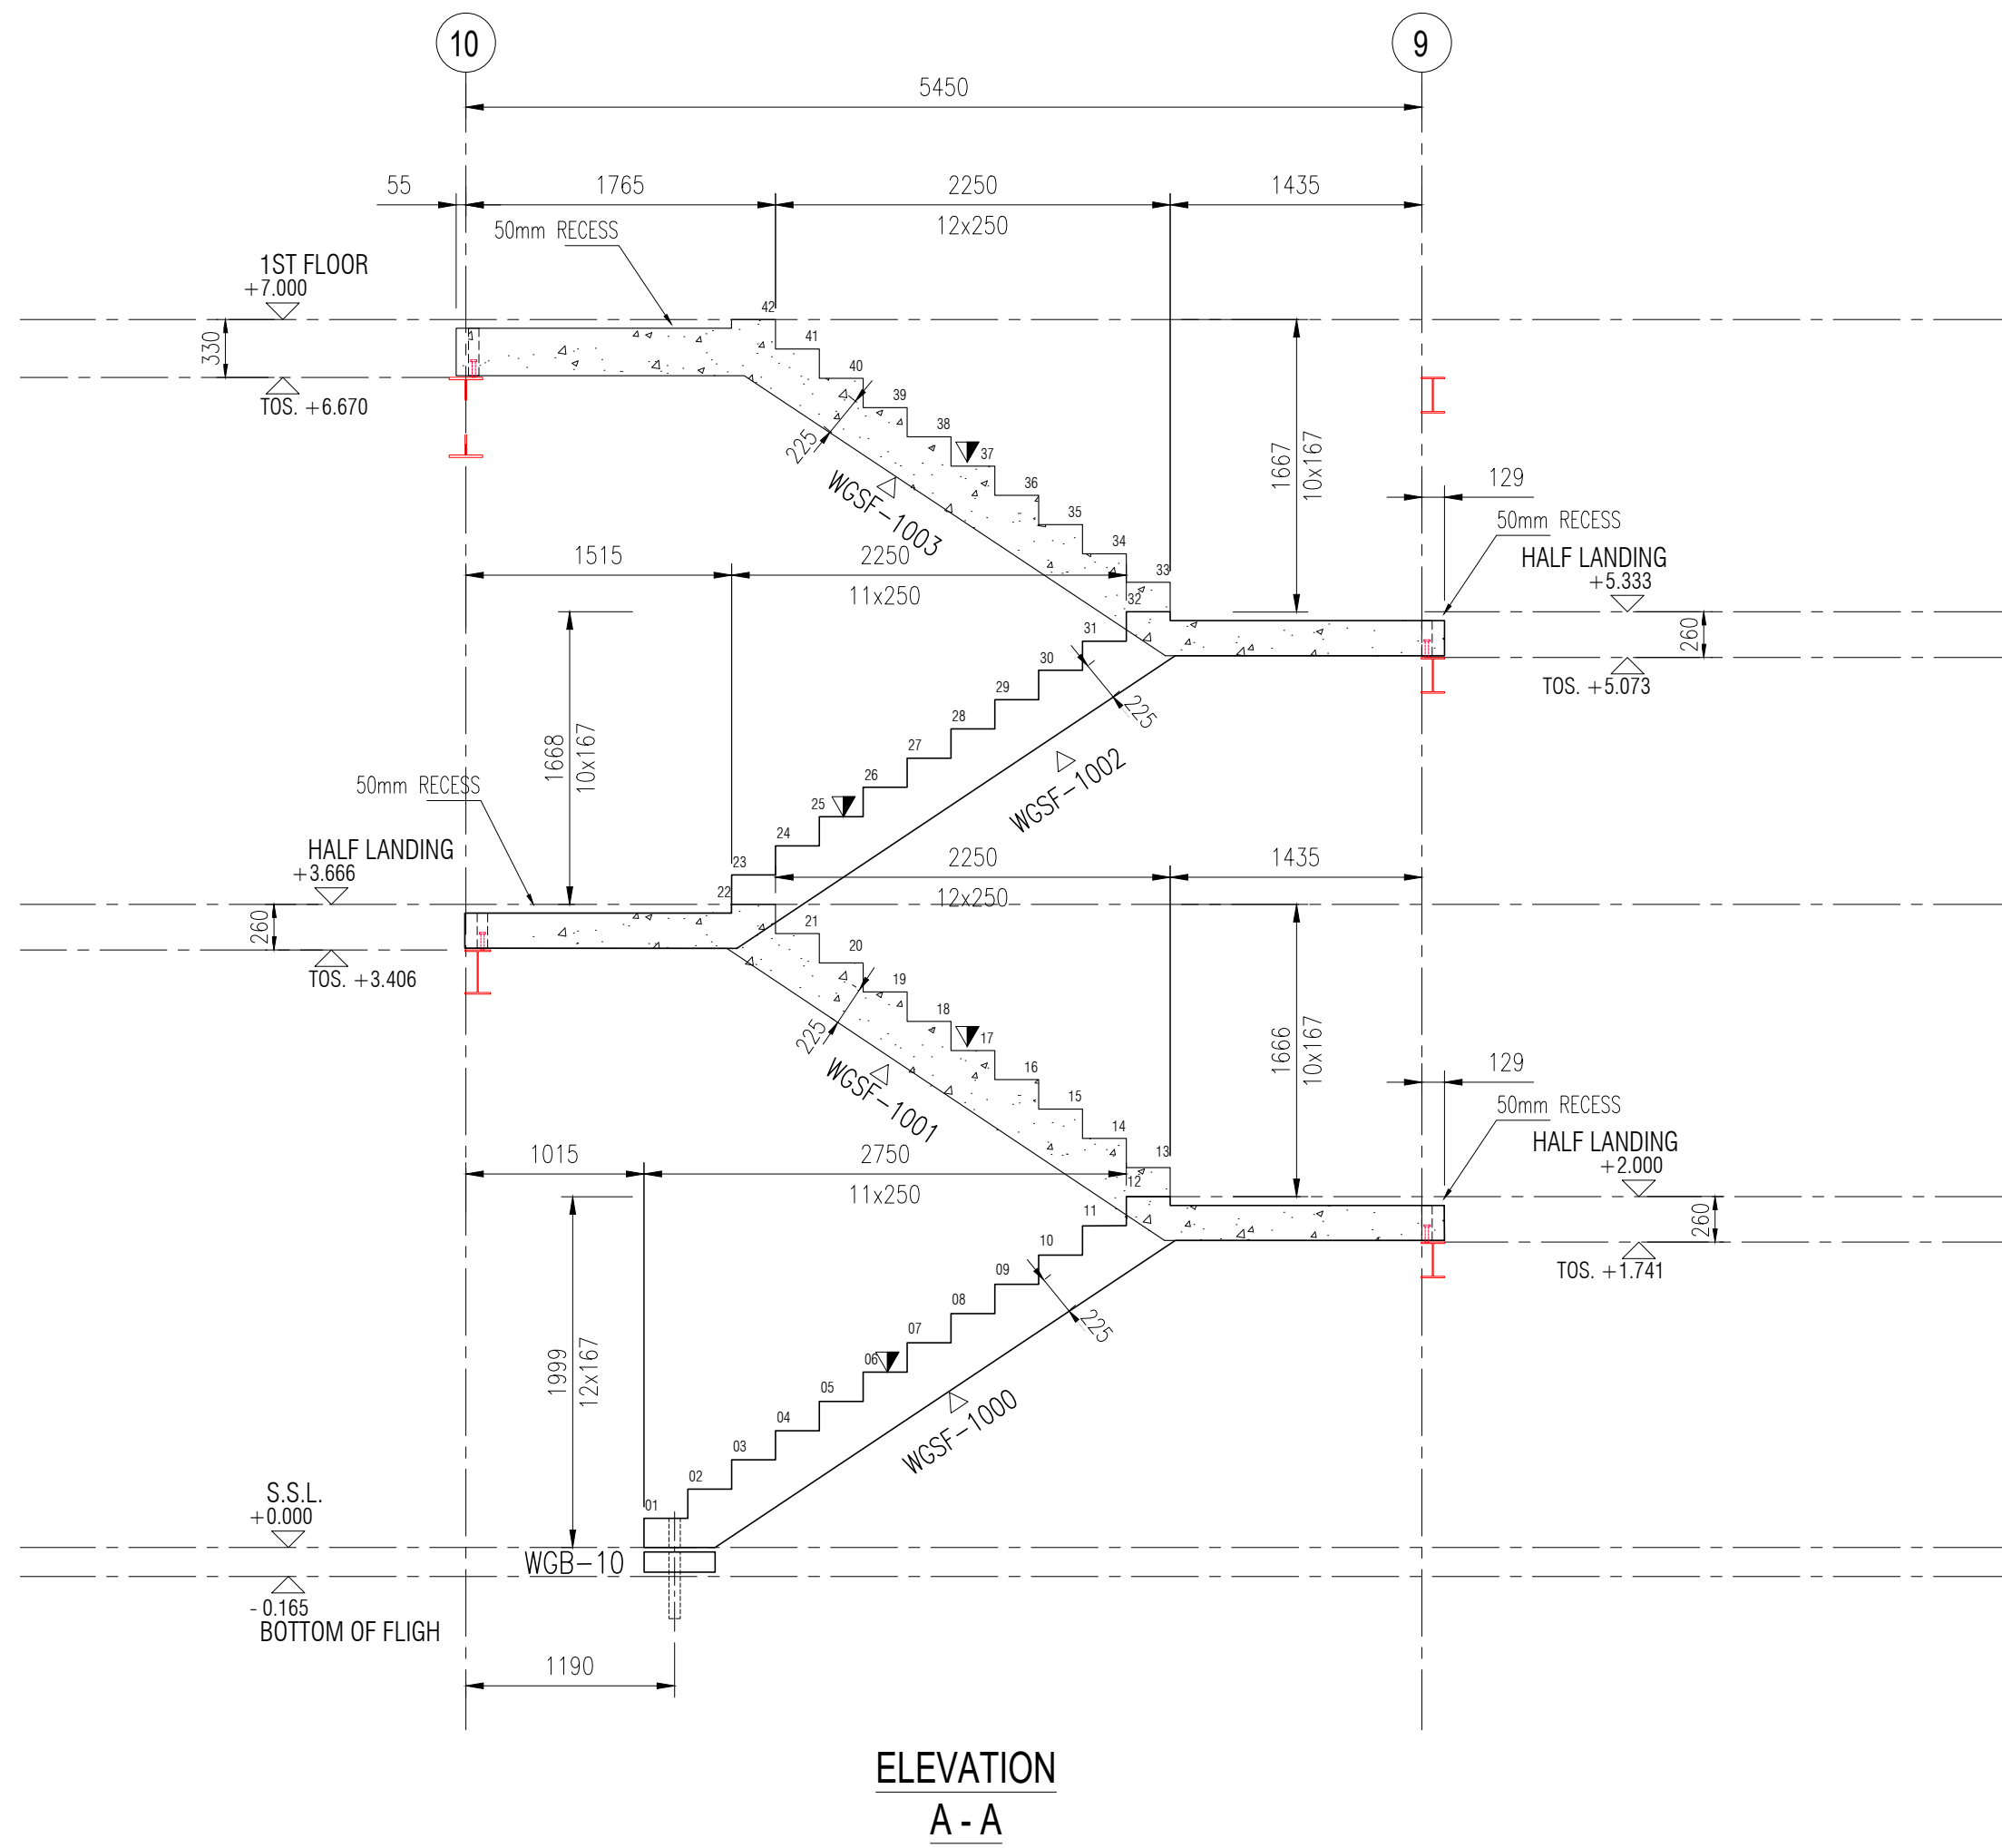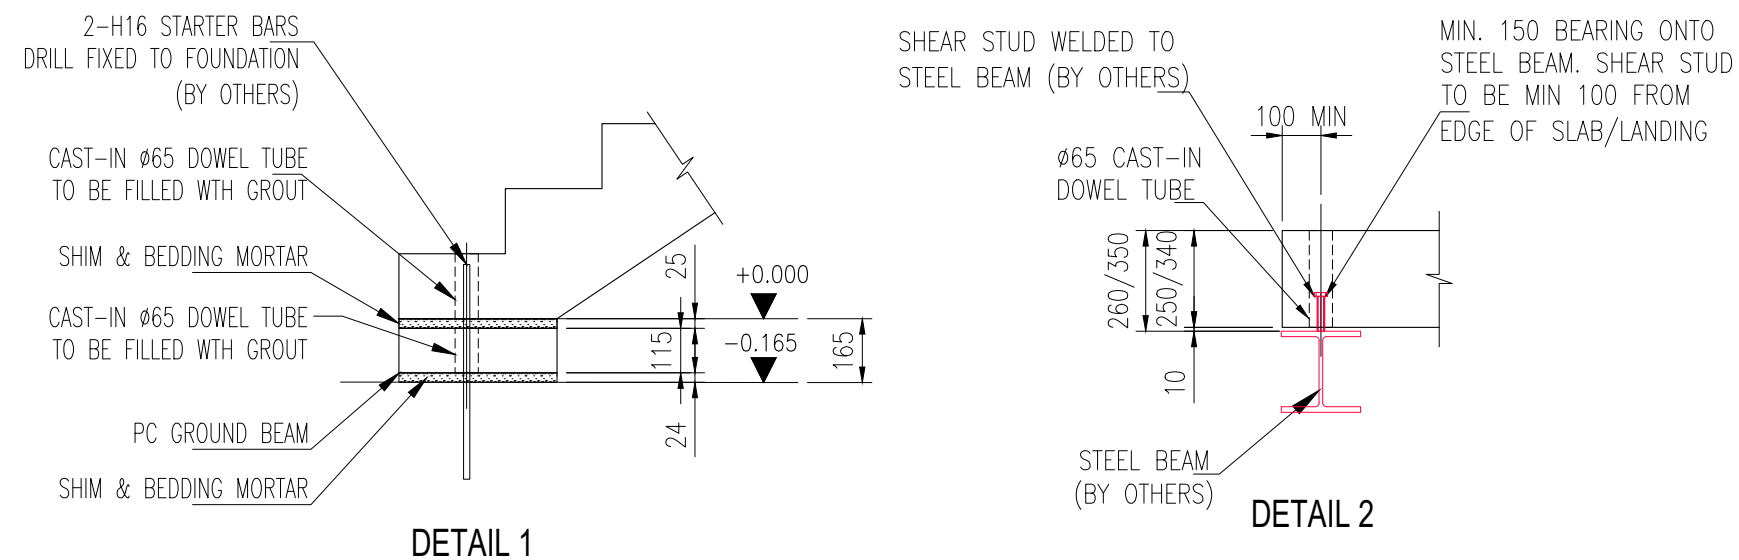

DRAWING PERTAINS TO PRECAST STAIR &
LANDING ELEMENTS ONLY. ENTIRE STEEL
FRAME BY OTHERS

SURFACE FINISHES

- ▼ = GOOD STEEL TROWEL FINISH
▽ = MOULD FINISH
▼ = POWER FLOAT FINISH



NOTE ON LIFTING UNITS:
ALL UNITS SHOULD BE LIFTED WITH [M/RD36] LIFTING LOOPS.

MAIN CONTRACTOR:

Winvic Construction Ltd

DESIGN NOTES

DESIGN NOTES
Concast have no responsibility for any structural elements other than their precast members. All other elements such as non precast walls (Loadbearing and Non-Loadbearing) and foundations are the responsibility of others.
Concast have no responsibility for holes / chases etc. cut in units unless performed in their works or written permission for same has been obtained.

AB	AS BUILT ISSUE	SH	MQ	13-02-2024
C1	ISSUED FOR CONSTRUCTION	SH	MQ	07-11-2023
P6	DETAIL 1 UPDATED TO MATCH REMAINING DETAILS	SH	MQ	06-11-2023
P5	LANDING NOTCH ADDED AROUND STEEL	MS	MQ	01-11-2023
P4	UPDATED TO LATEST ARCHITECT COMMENTS	SH	MQ	26-10-2023
P3	UPDATED TO COMMENTS AND LATEST STEEL	SH	MQ	18-10-2023
P2	UPDATED TO FIRST COMMENTS	SH	MQ	09-10-2023
P1	FIRST ISSUE	SH	MQ	02-10-2023
REV	DESCRIPTION	DRAWN	CHECKED	DATE

AS BUILT



Structural Precast
Concrete Contractors

Tel: (01) 6288055 Fax: (01) 6272326/6288104
Email : info@concastprecast.co.uk

THIS DRAWING AND ANY DESIGN HEREON IS THE PROPERTY OF CONCAST PRECAST LIMITED AND MUST NOT BE REPRODUCED WITHOUT THEIR WRITTEN CONSENT.


Do Not Scale From Drawing. Use Figured Dimensions Only

DATE	SEP 2023	JOB No.	2023-935	REV	AB
SCALE	NTS	DRAWING No.	P23012-CON-XY-XY-DR-X-0370		


PROJECT
PLOT 3 WINGATES BOLTON

TITLE	STAIR - GENERAL ARRANGEMENT
-------	-----------------------------


DESIGN NOTES
Concast have no responsibility for any structural elements other than their precast members. All other elements such as non precast walls (Loadbearing and Non-Loadbearing) and foundations are the responsibility of others.
Concast have no responsibility for holes / chases etc. cut in units unless performed in their works or written permission for same has been obtained.

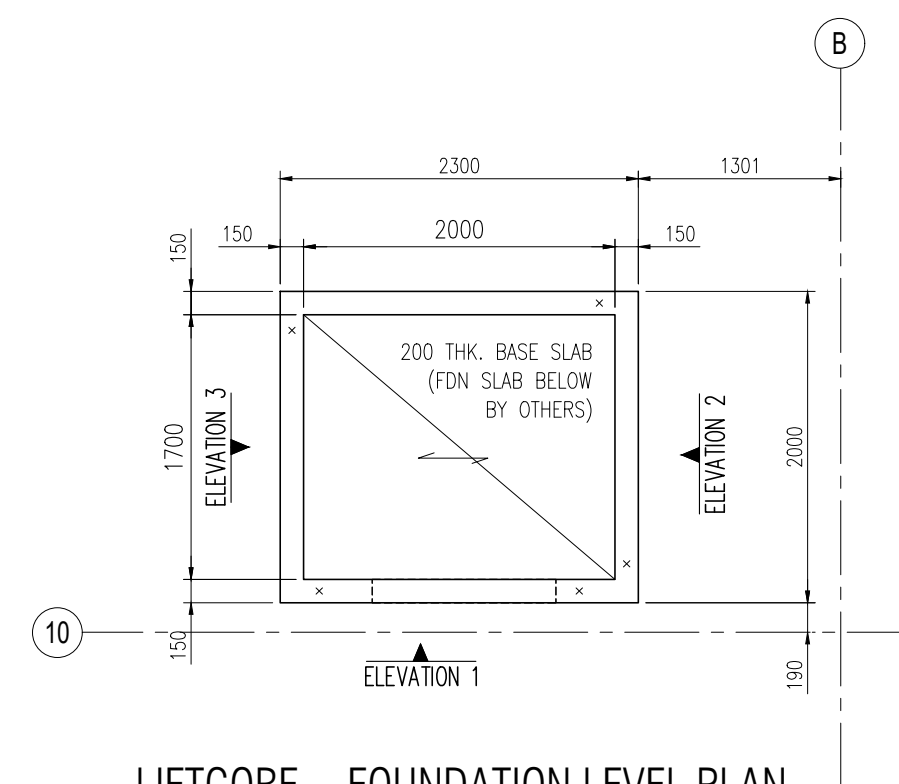


LIFTCORE - FOUNDATION LEVEL PLAN
(-1.325)

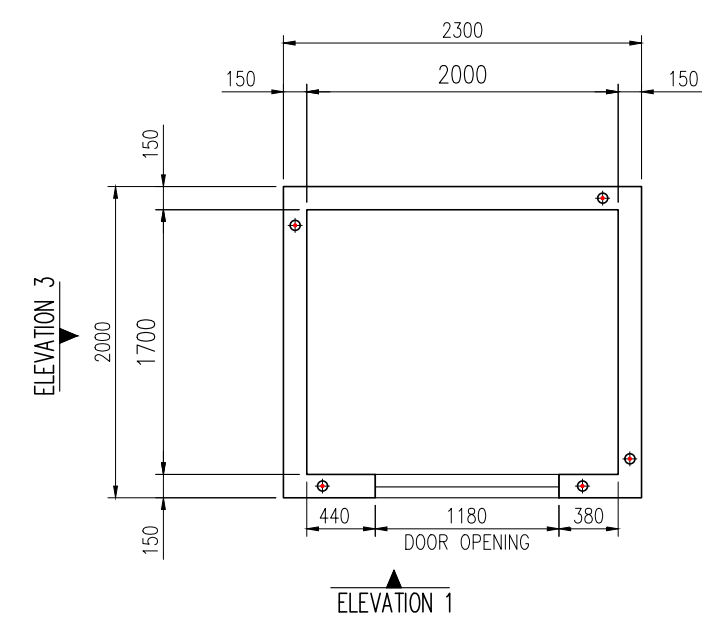


LIFTCORE - LEVEL 0 PLAN
(0.00)

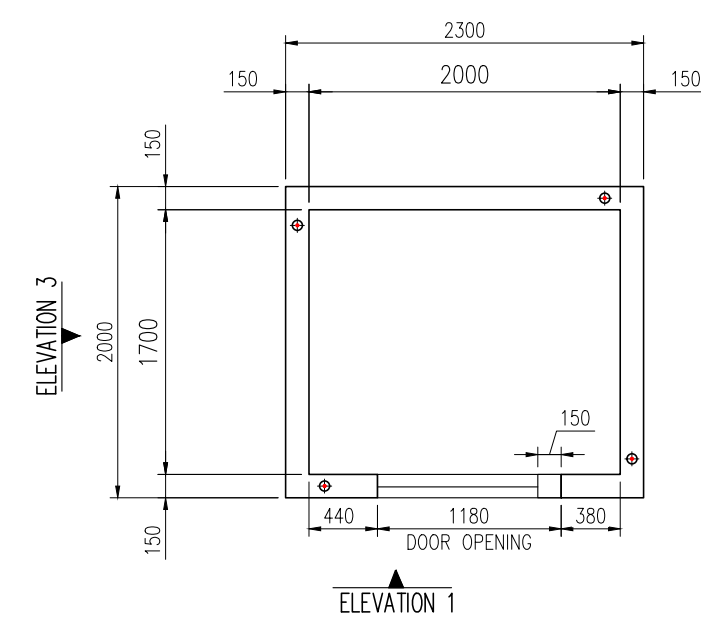


LIFTCORE - LEVEL 1 PLAN
(7.000)

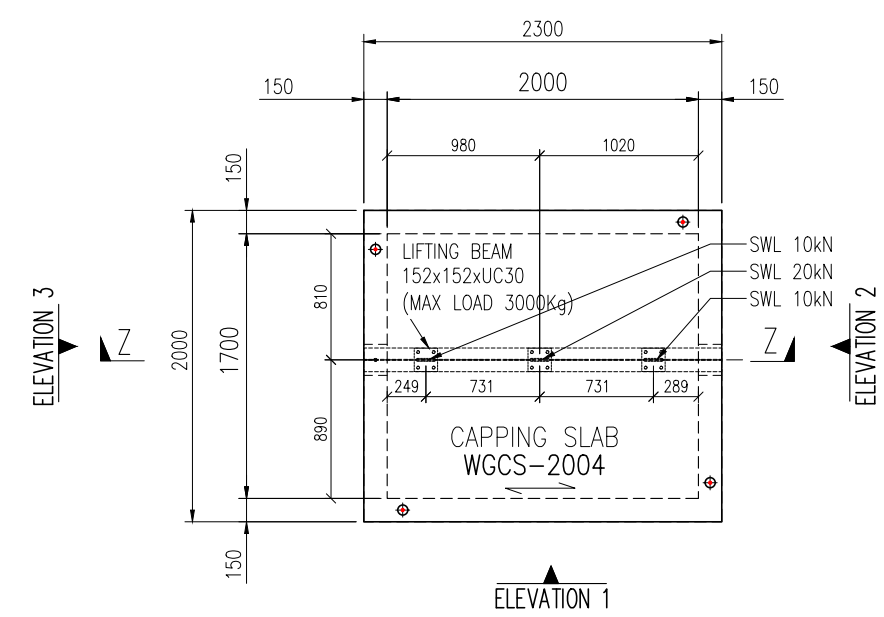


LIFTCORE - CAPPING SLAB LEVEL PLAN
(10.800)

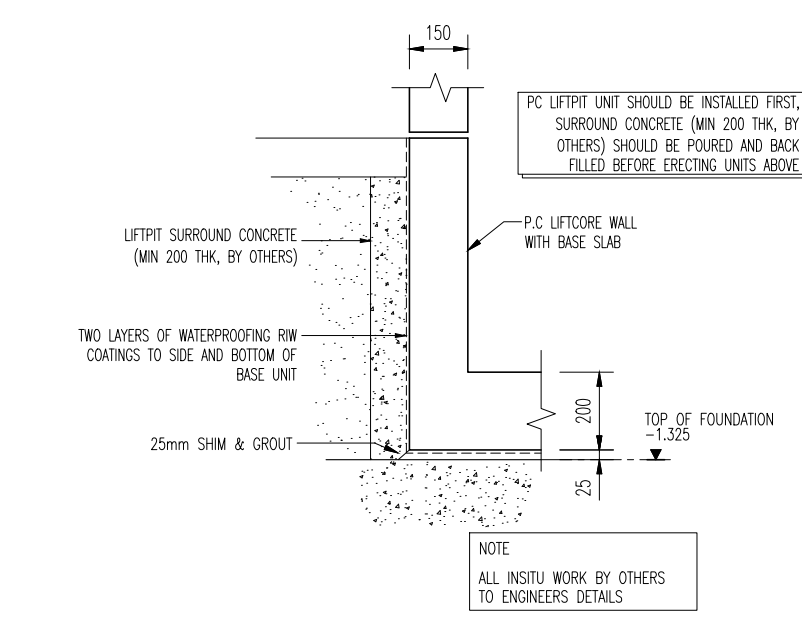


TYPICAL WALL-BASE
CONNECTION DETAIL

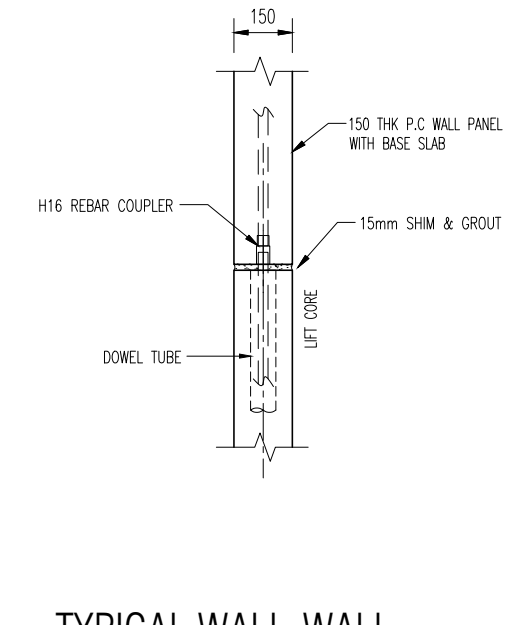


TYPICAL WALL-WALL
CONNECTION DETAIL

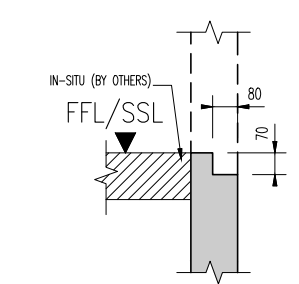


SECTION X-X

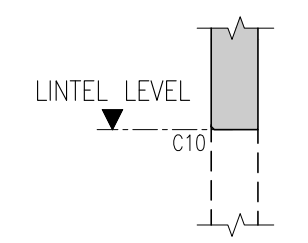


SECTION Y-Y

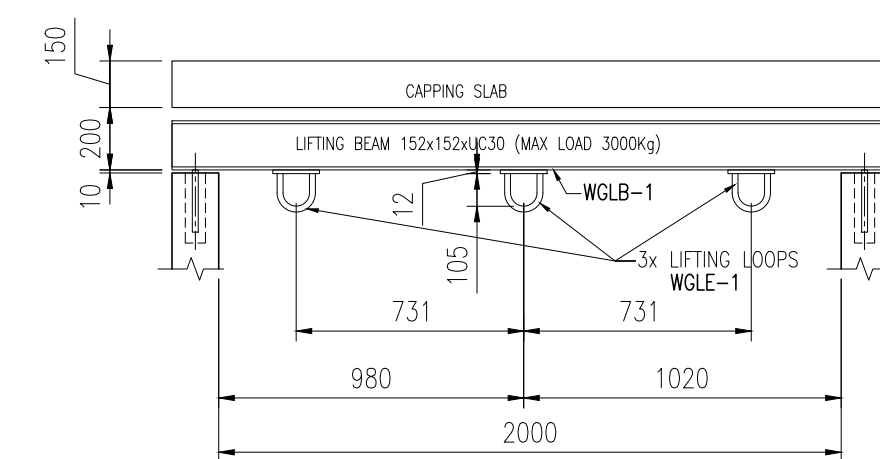


SECTION Z-Z

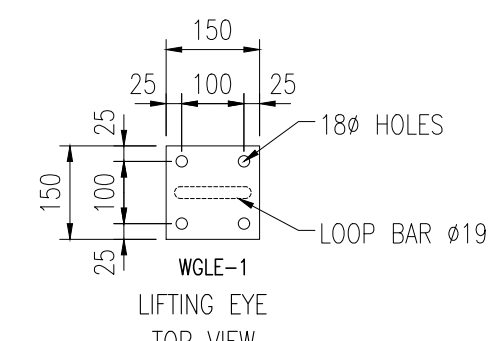

WGLC-1
LIFTING EYE
TOP VIEW

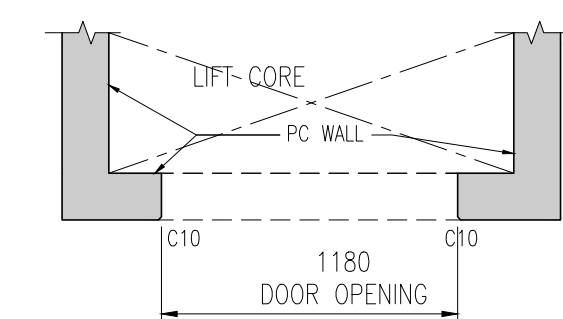


WALL PANEL PLAN

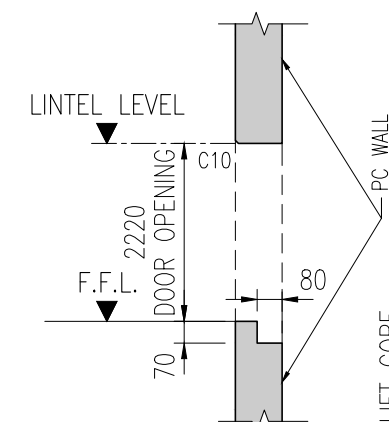


WALL PANEL SECTION


CHAMFER DETAIL
C10 = 10x10 CHAMFER

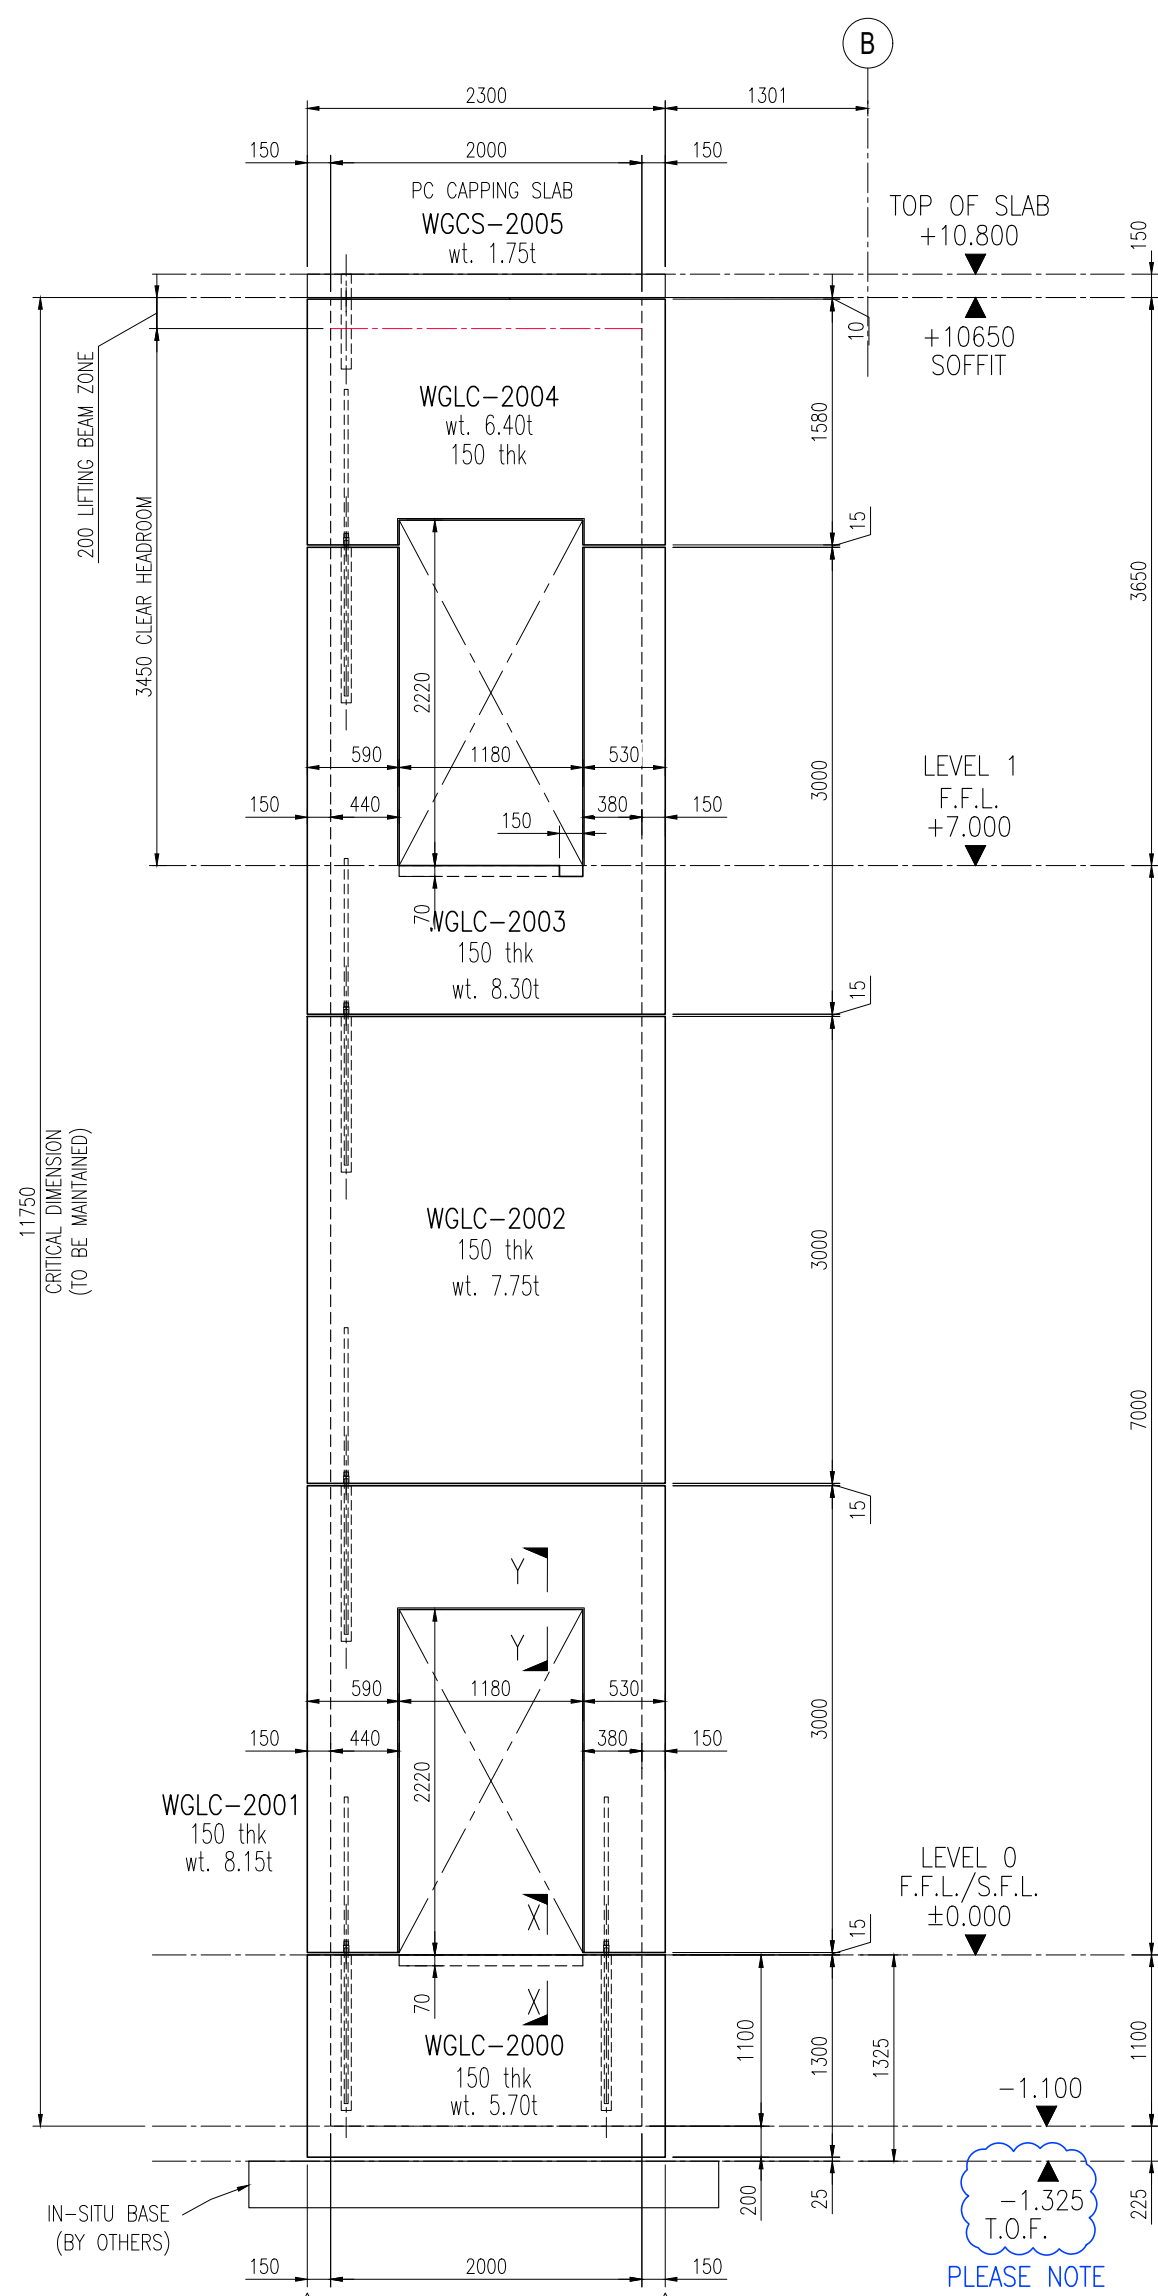

ELEVATION - 1
LIFTCORE

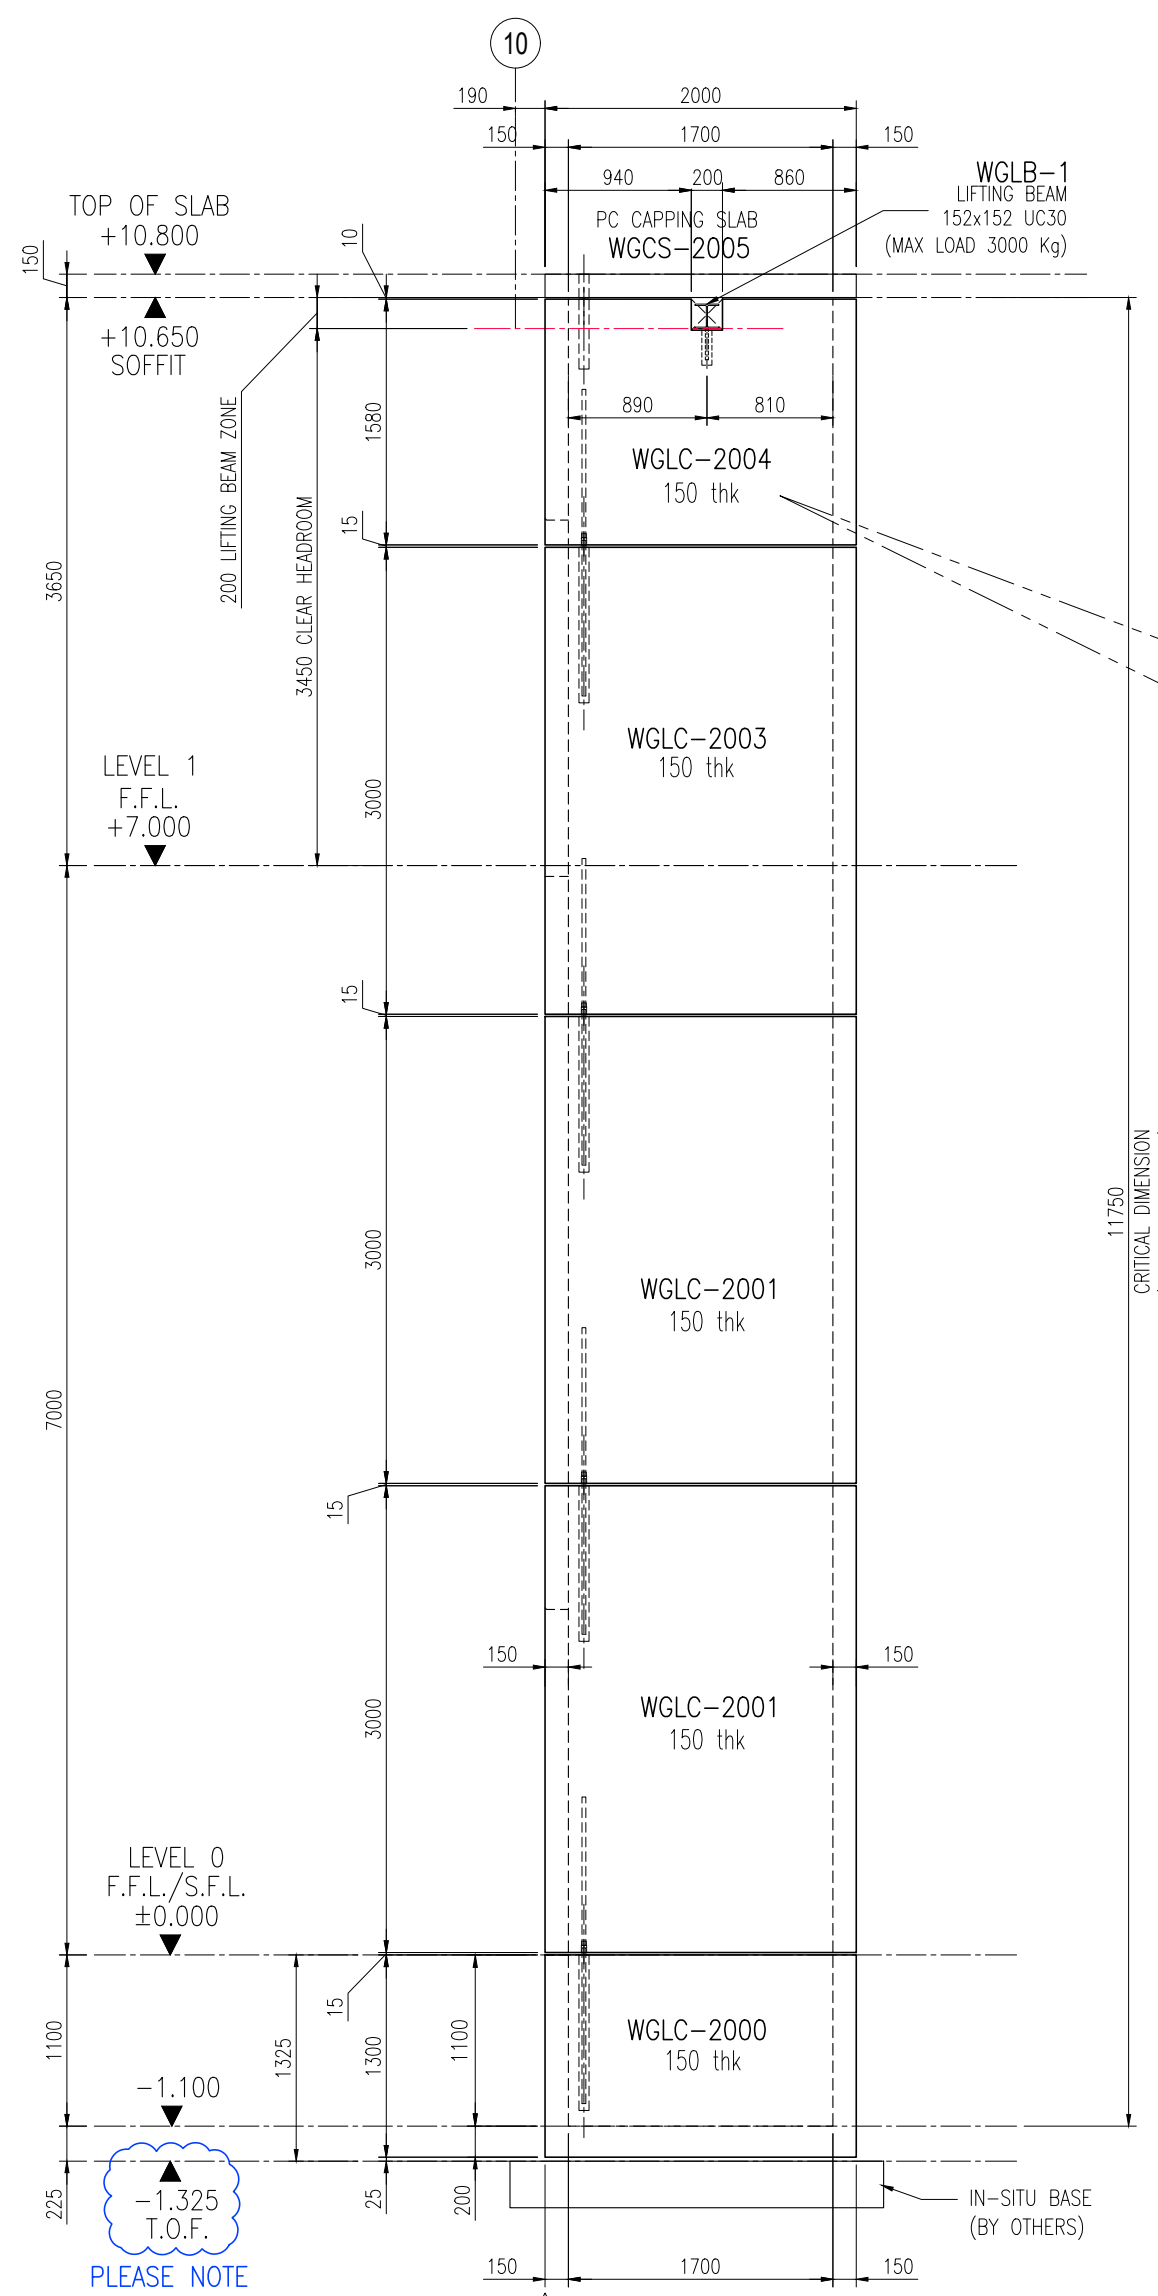

ELEVATION - 2
LIFTCORE

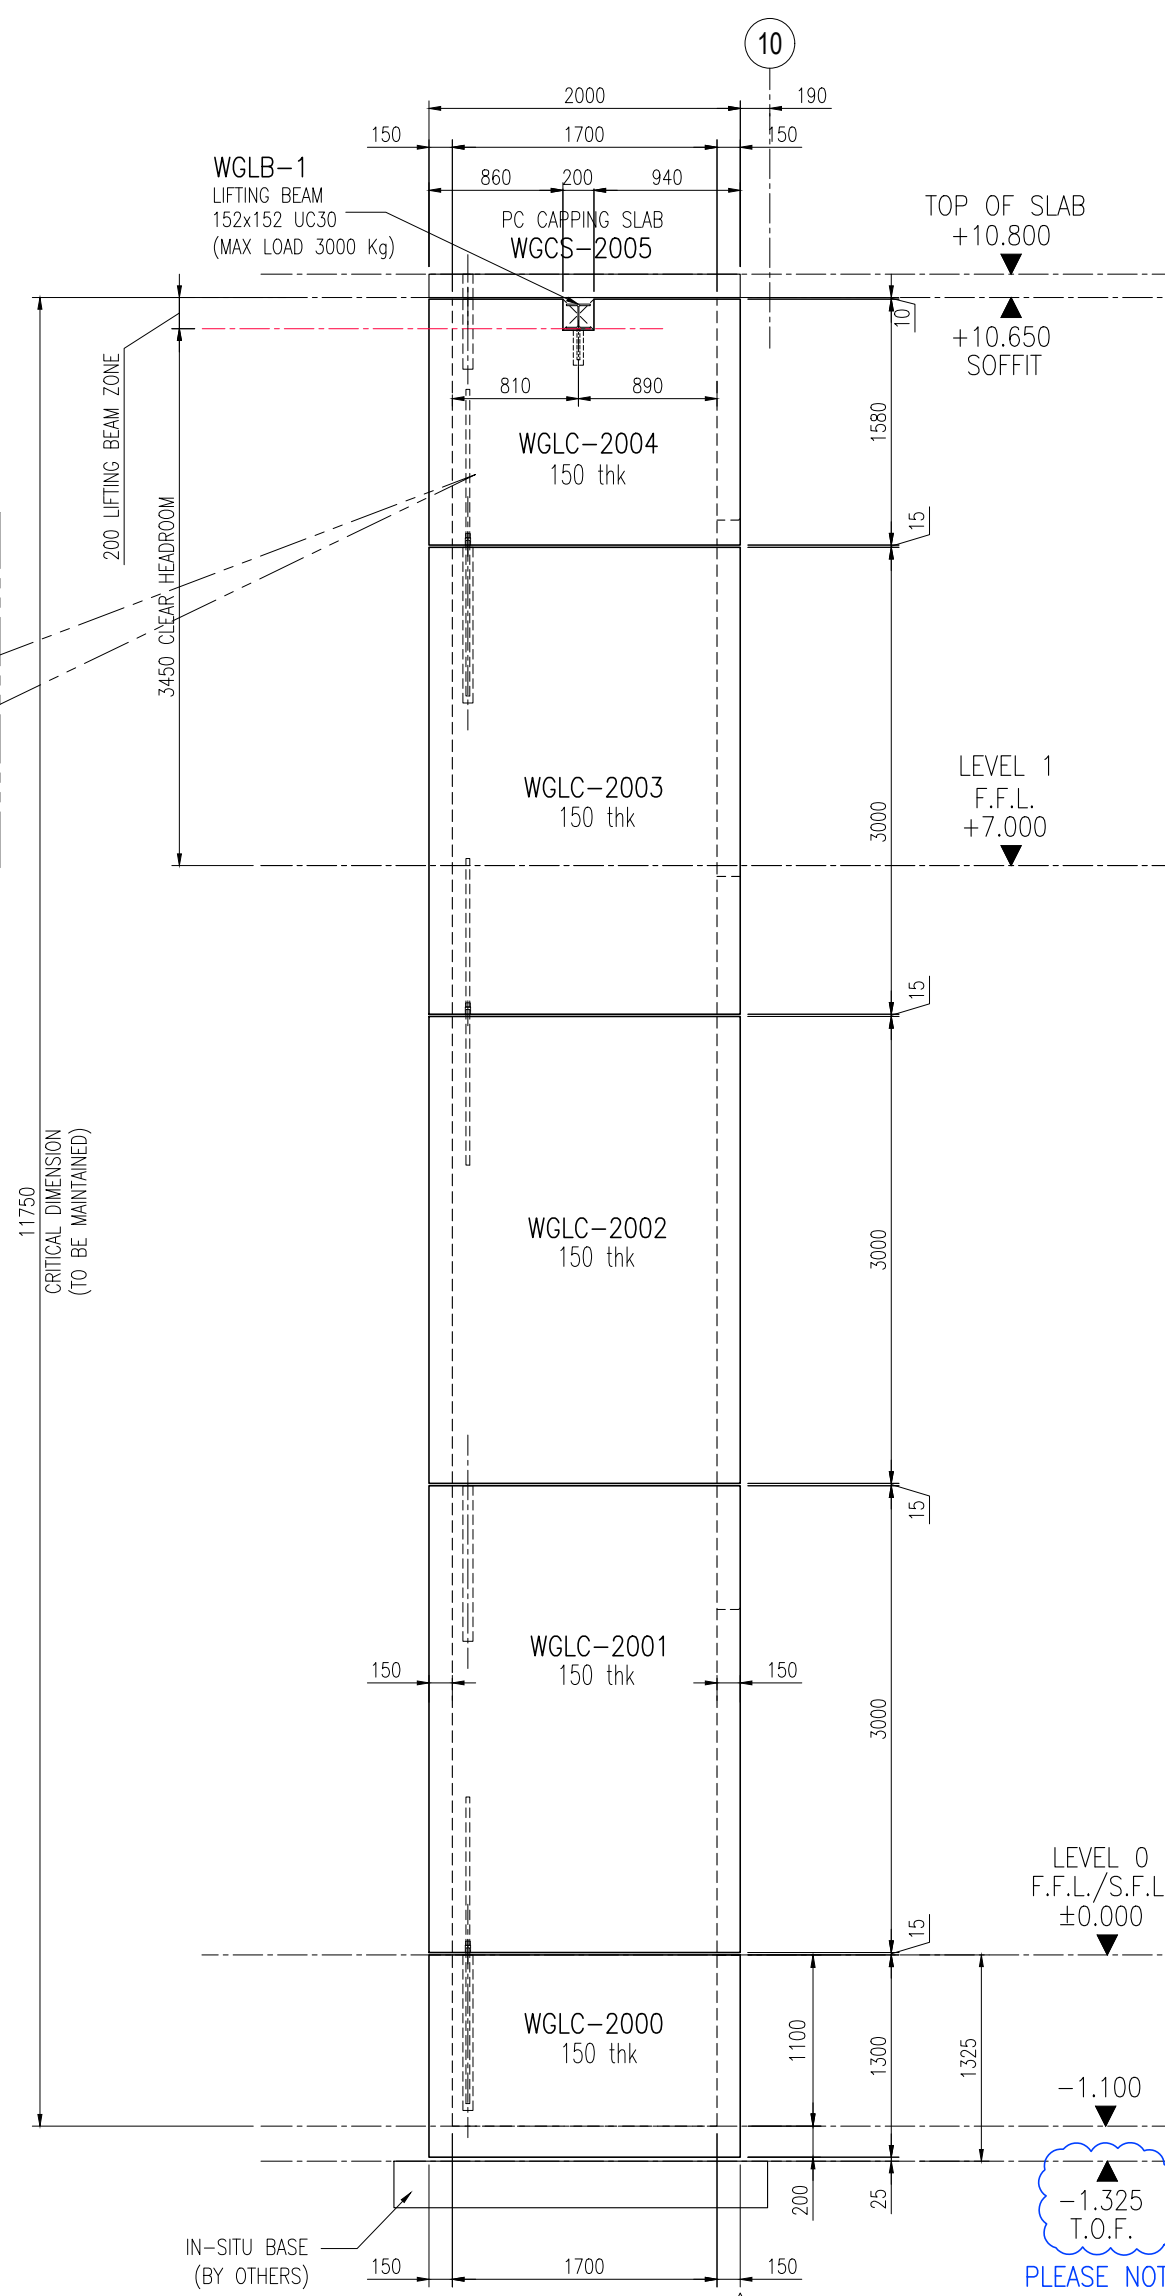


ELEVATION - 3
LIFTCORE



NOTE ON LIFTING UNITS:
ALL UNITS SHOULD BE LIFTED WITH [M/RD42] LIFTING LOOPS.

REV	DESCRIPTION	DATE
AB	AS BUILT ISSUE	13/02/2024
C2	REVISED FOLLOWING RECEIPT OF LATEST LIFT INFO	25/10/2023
C1	ISSUED FOR CONSTRUCTION	12/10/2023
P2	SET OUT CONFIRMED & 1ST FLOOR LEVEL ALTERED	05/10/2023
P1	FIRST ISSUE	27/09/2023

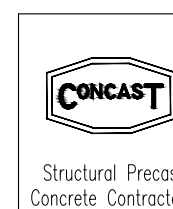

CONCAST
Hazelhatch Road Newcastle Co. Dublin
Tel: (01) 6288055 Fax: (01) 6272326/6288104
Email: info@concastprecast.co.uk

THIS DRAWING AND ANY DESIGN HEREON IS THE PROPERTY OF CONCAST PRECAST LIMITED AND MUST NOT BE REPRODUCED WITHOUT THEIR WRITTEN CONSENT.

DATE	SEP 2023	JOB No.	2023-935	REV	AB
SCALE	AS SHOWN	DRAWING No.	P23012-CON-XX-XX-DR-X-0380		
PROJECT	PLOT 3 WINGATES BOLTON				
TITLE	LIFT CORE, GENERAL ARRANGEMENT				

MAIN CONTRACTOR:
Winvic Construction Ltd

AS BUILT

Do Not Scale From Drawing. Use Figured Dimensions Only