

P23012 Wingates Plot 3

Drawing Register: G&A


*Please note: All drawings listed below are hyperlinked to the drawings listed.
Please click on the drawing title to go directly to the drawing of your choice.*

Works Completed: Passive

Fire Protection

Drawing No.	Drawing Title	Rev
12737-GAF-03-00-DR-X-0001	3D View	ZZ
12737-GAF-03-00-DR-X-0002	Main Office Plans	ZZ
12737-GAF-03-00-DR-X-0003	Elevations	ZZ

SPECIFICATION:
Euroclad Firemaster Wall
Extra 150mm thick
RAL - 9010

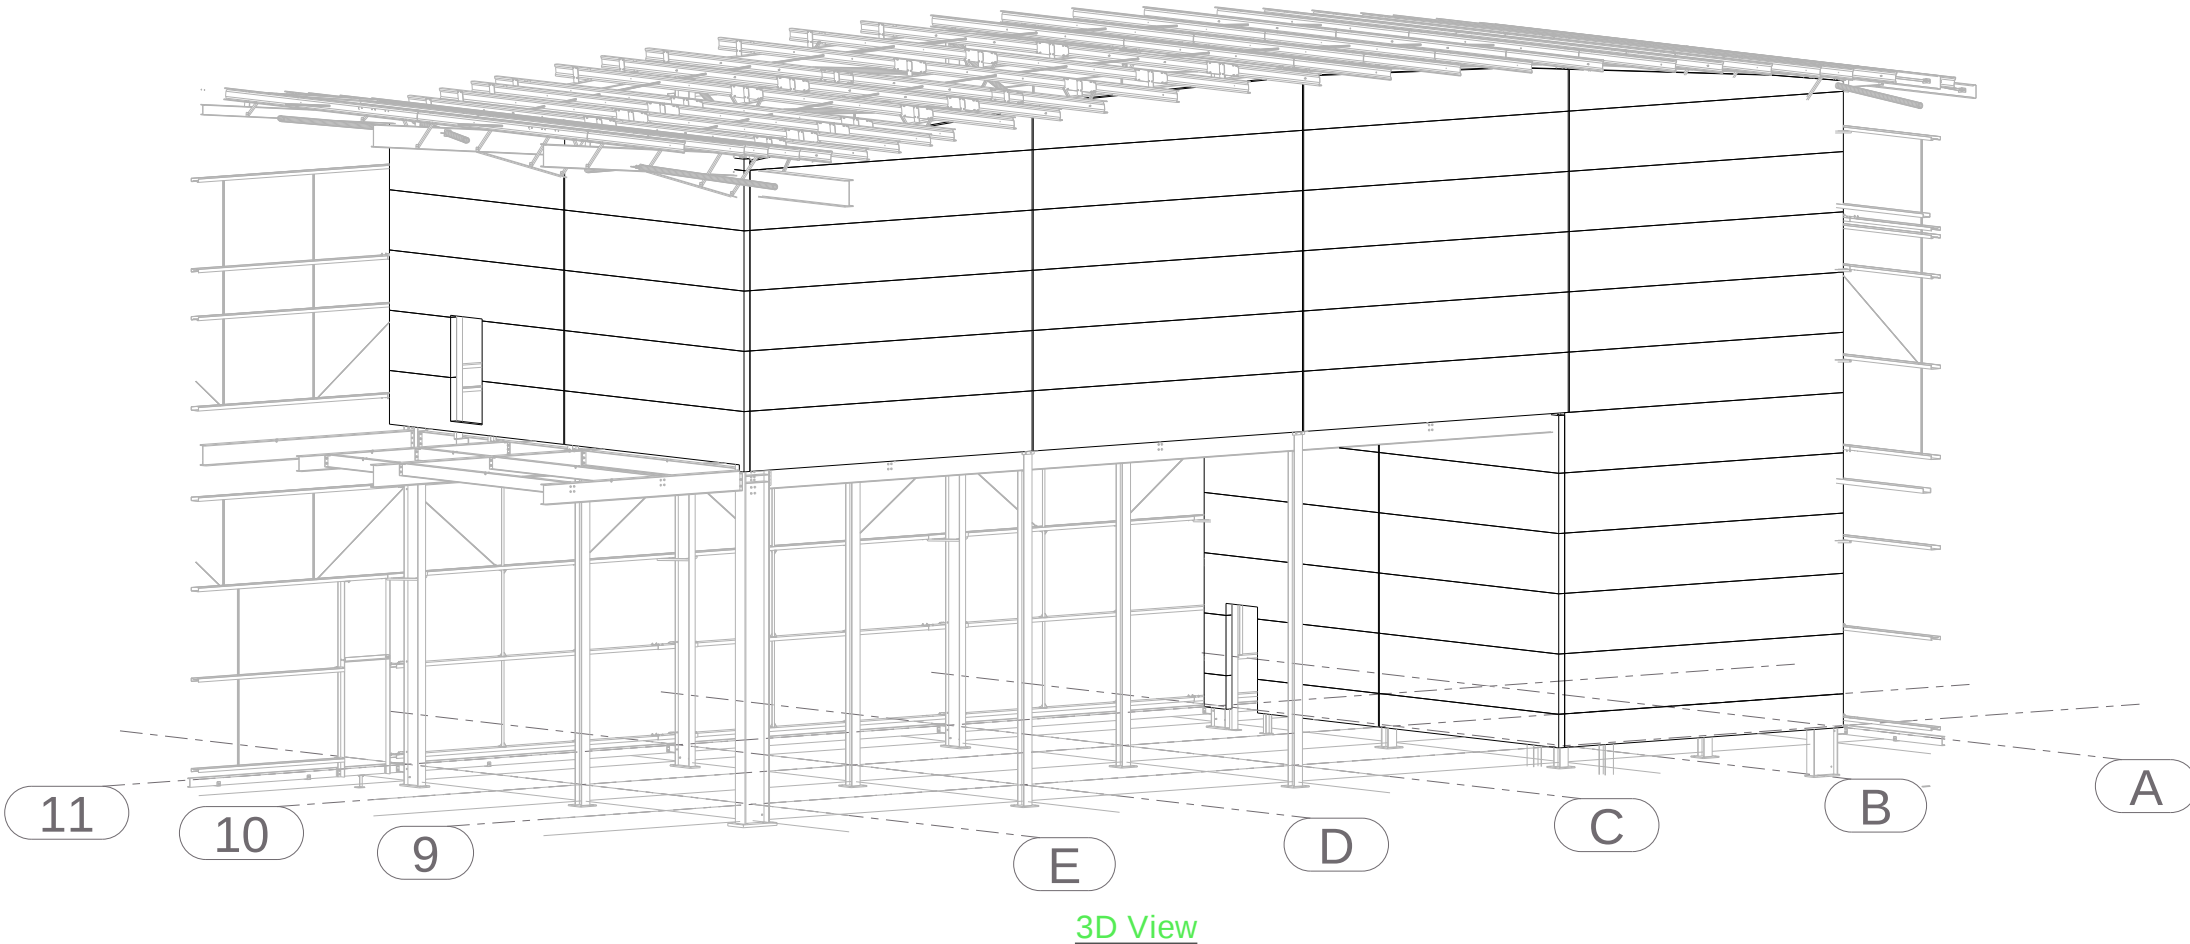

ZZ	As-built	26.04.2024
P03	Comments 12/1/24	16.01.2024
P02	Comments 6/12/23	10.01.2024
P01	Prelim Issue	27.11.2023
C02	Aligned Panels	08.03.2024
C01	Construction	16.02.2024
REV MARK	REVISION DESCRIPTION	REVISION DATE

Drawing Status :
AS-BUILT



Fire Protection & Interior Services
Specialist Contractor

Unit J2
Valley Way
Welland Industrial Estate
Market Harborough
LE16 7PS

tel:01858 432222
email: info@ga-group.com
www.ga-fireprotection.co.uk



Client :
Project :
Plot 3 Bolton

Contract No. :
Drawing Title :
3D View

Weight :
Scale :

Drawn By : AC
Drawing Number :
12737-GAF-03-00-DR-X-0001

Date :
Revision :
ZZ


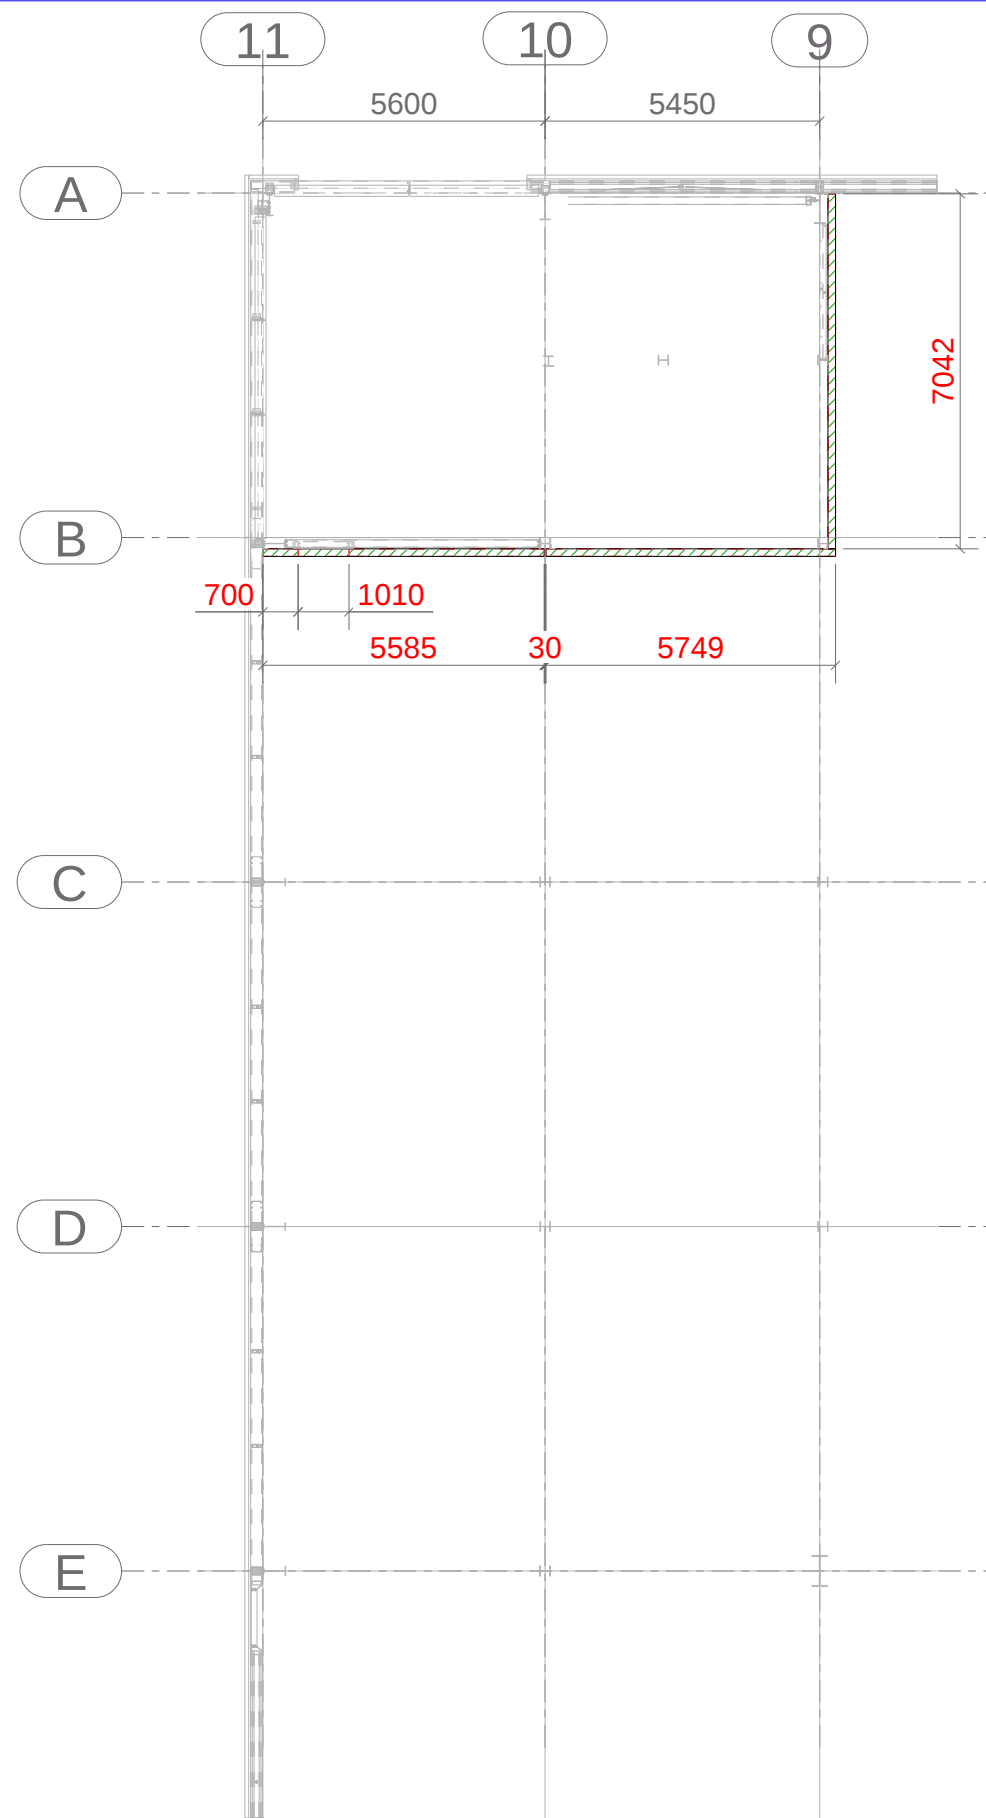
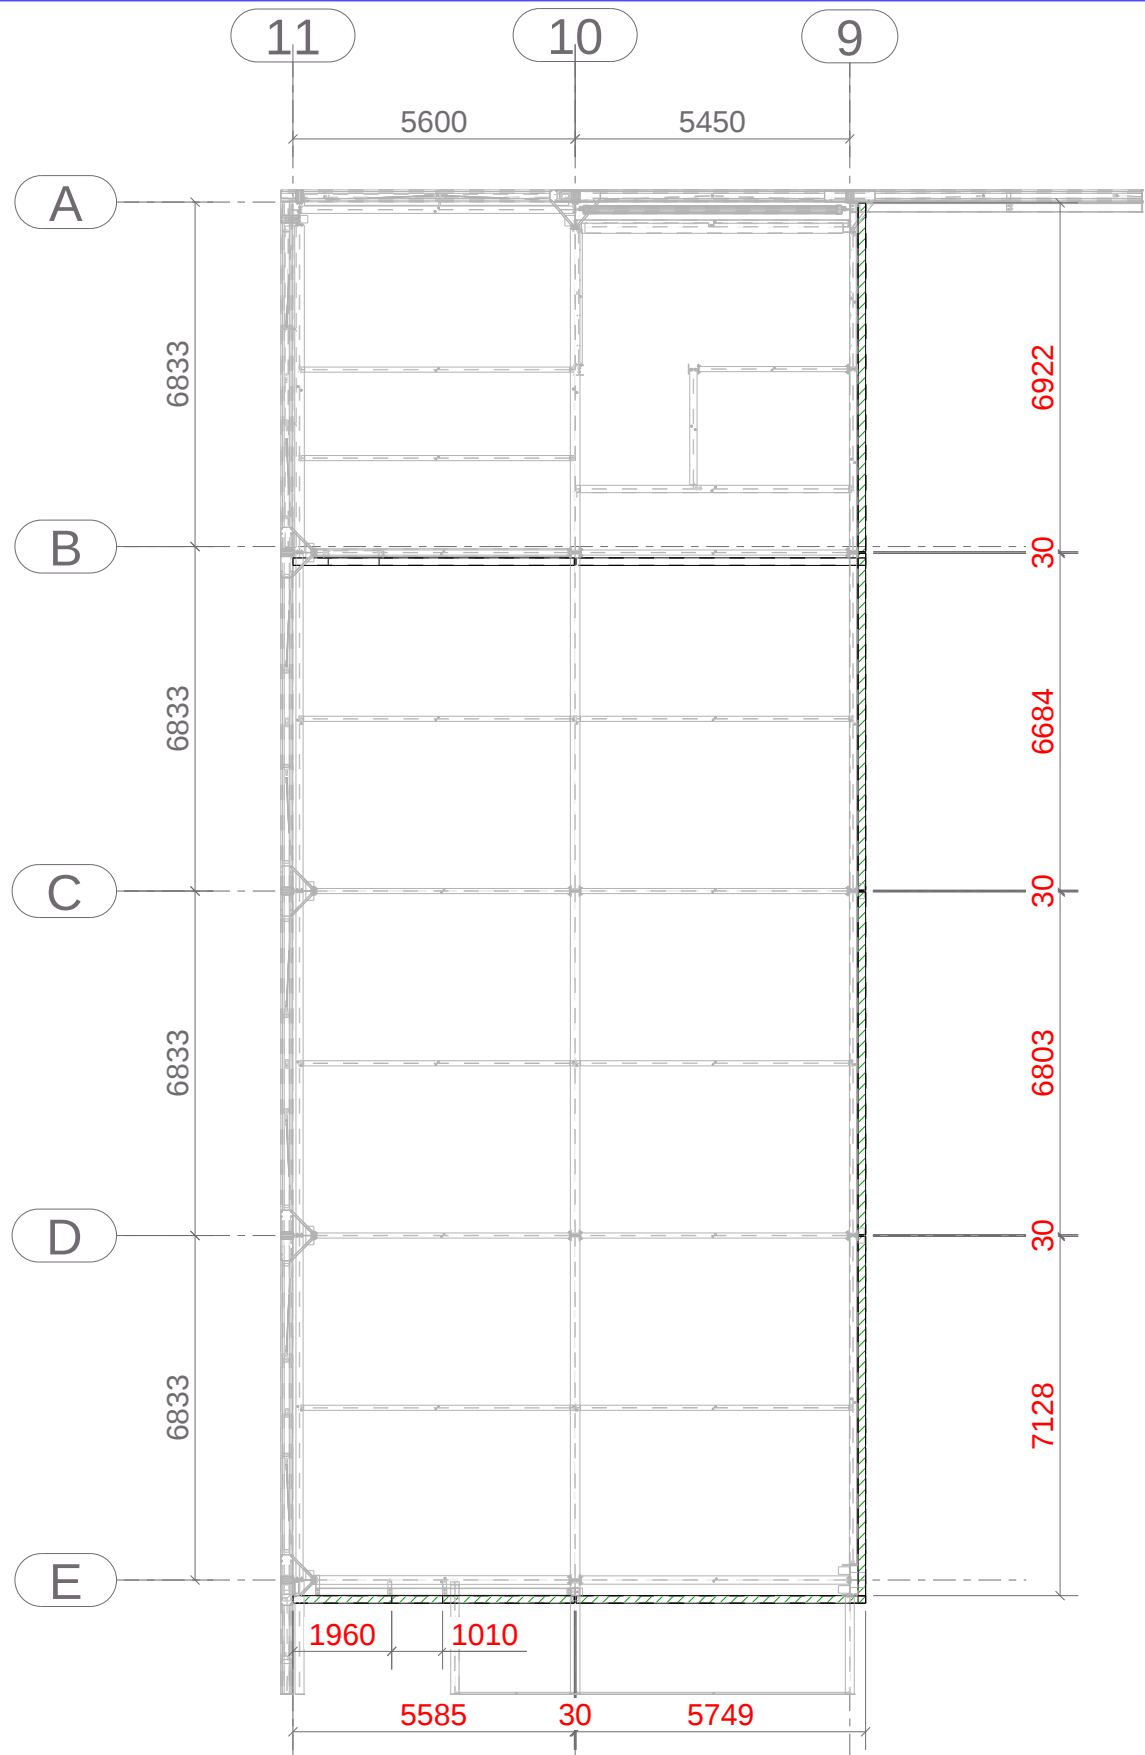


ZZ	As-built	26.04.2024
P03	Comments 12/1/24	16.01.2024
P02	Comments 6/12/23	10.01.2024
P01	Prelim Issue	27.11.2023
C02	Aligned Panels	08.03.2024
C01	Construction	16.02.2024
REV MARK	REVISION DESCRIPTION	REVISION DATE

SPECIFICATION:
Euroclad Firemaster Wall
Extra 150mm thick
RAL - 9010






Drawing Status :
AS-BUILT

	Fire Protection & Interior Services Specialist Contractor	Unit J2 Valley Way Welland Industrial Estate Market Harborough LE16 7PS	tel:01858 432222 email: info@ga-group.com www.ga-fireprotection.co.uk	Client :	Contract No. :	Weight :	Drawn By : AC	Date :
				Project : Plot 3 Bolton	Drawing Title : Main Office Plans	Scale :	Drawing Number : 12737-GAF-03-00-DR-X-0002	Revision : ZZ

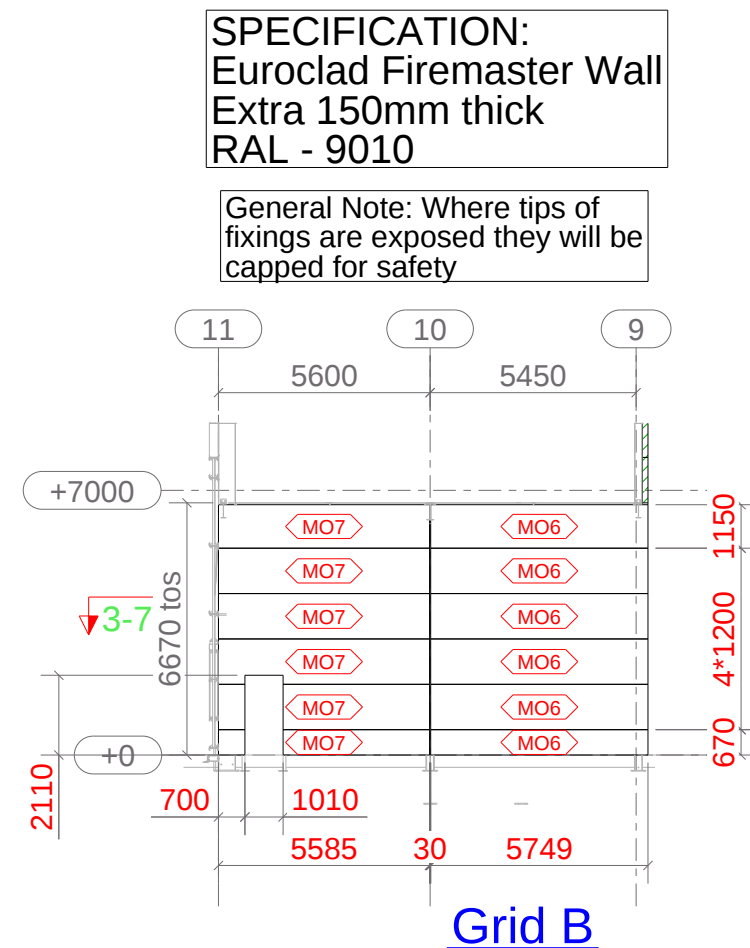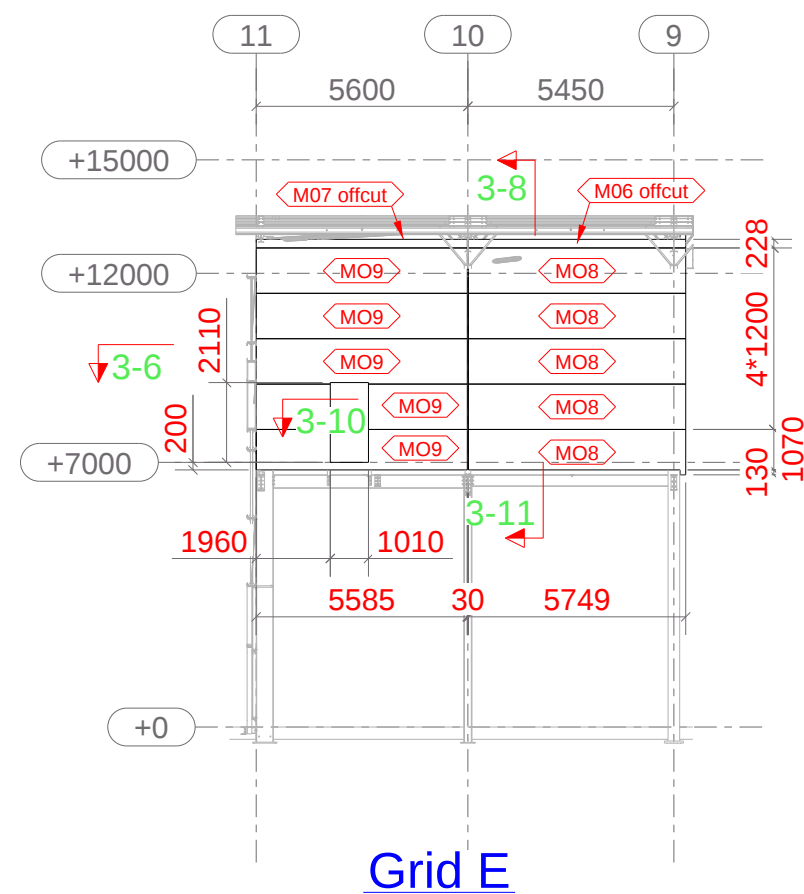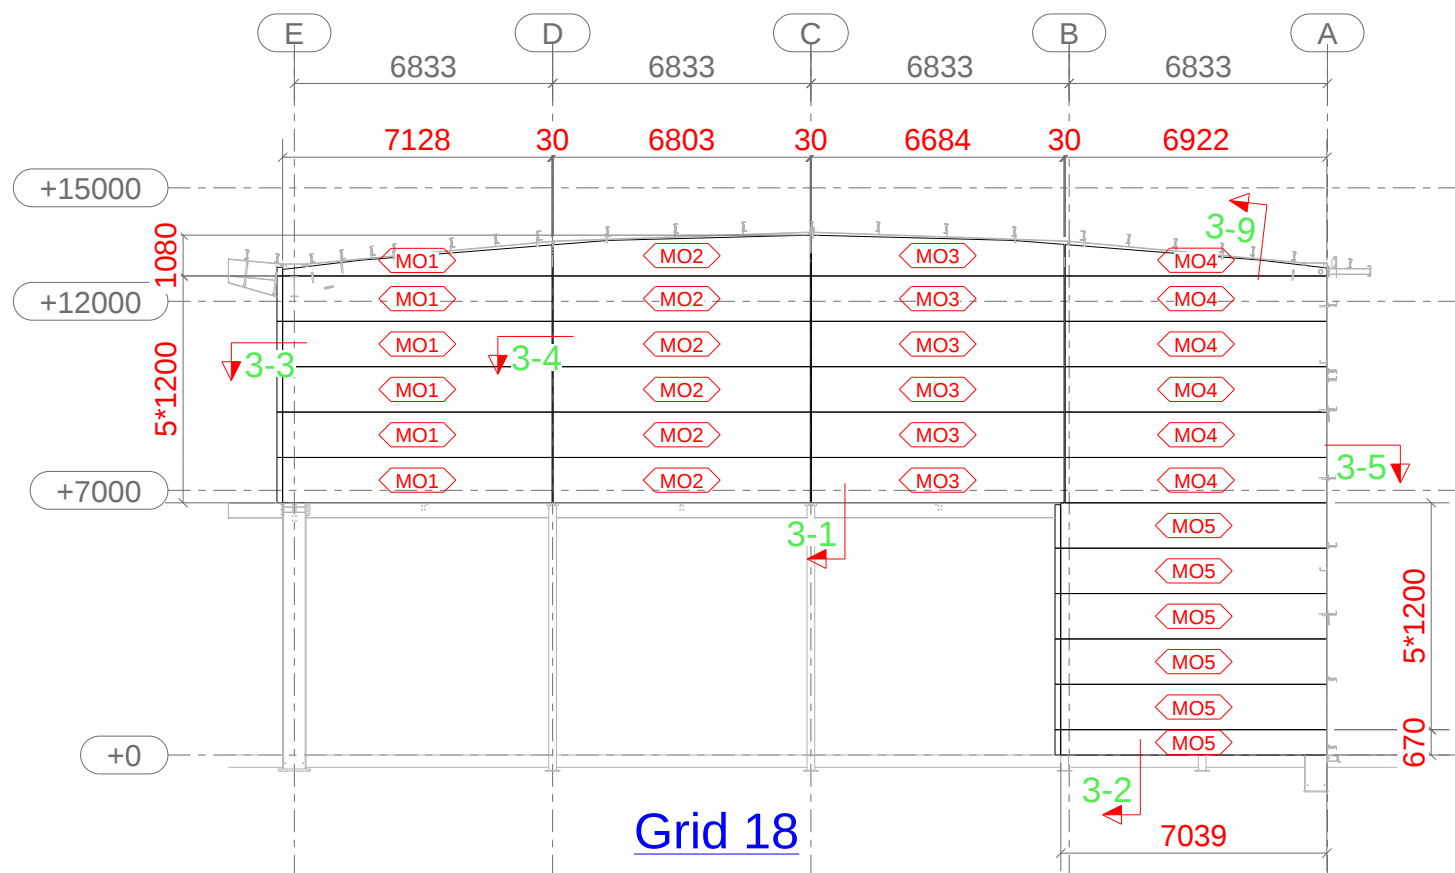

SPECIFICATION:
Euroclad Firemaster Wall
Extra 150mm thick
RAL - 9010

General Note: Where tips of fixings are exposed they will be capped for safety

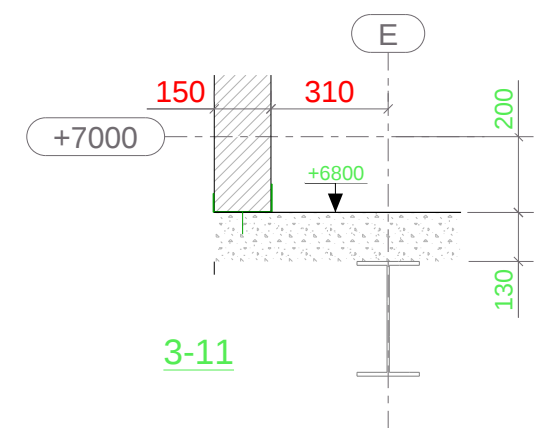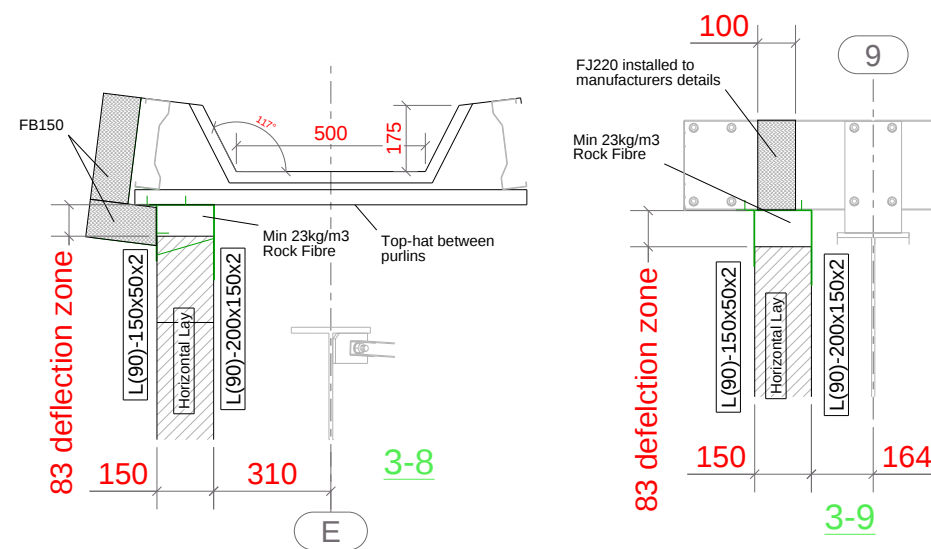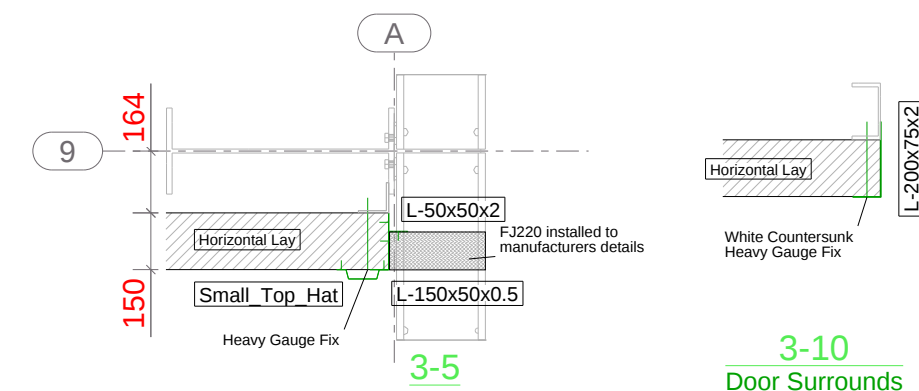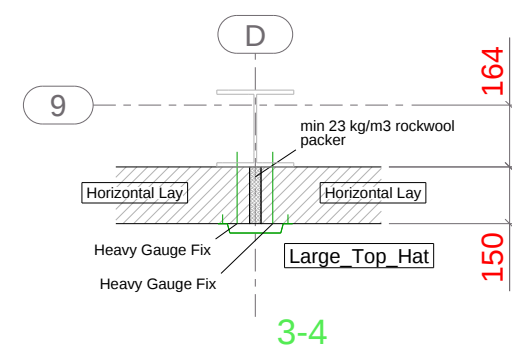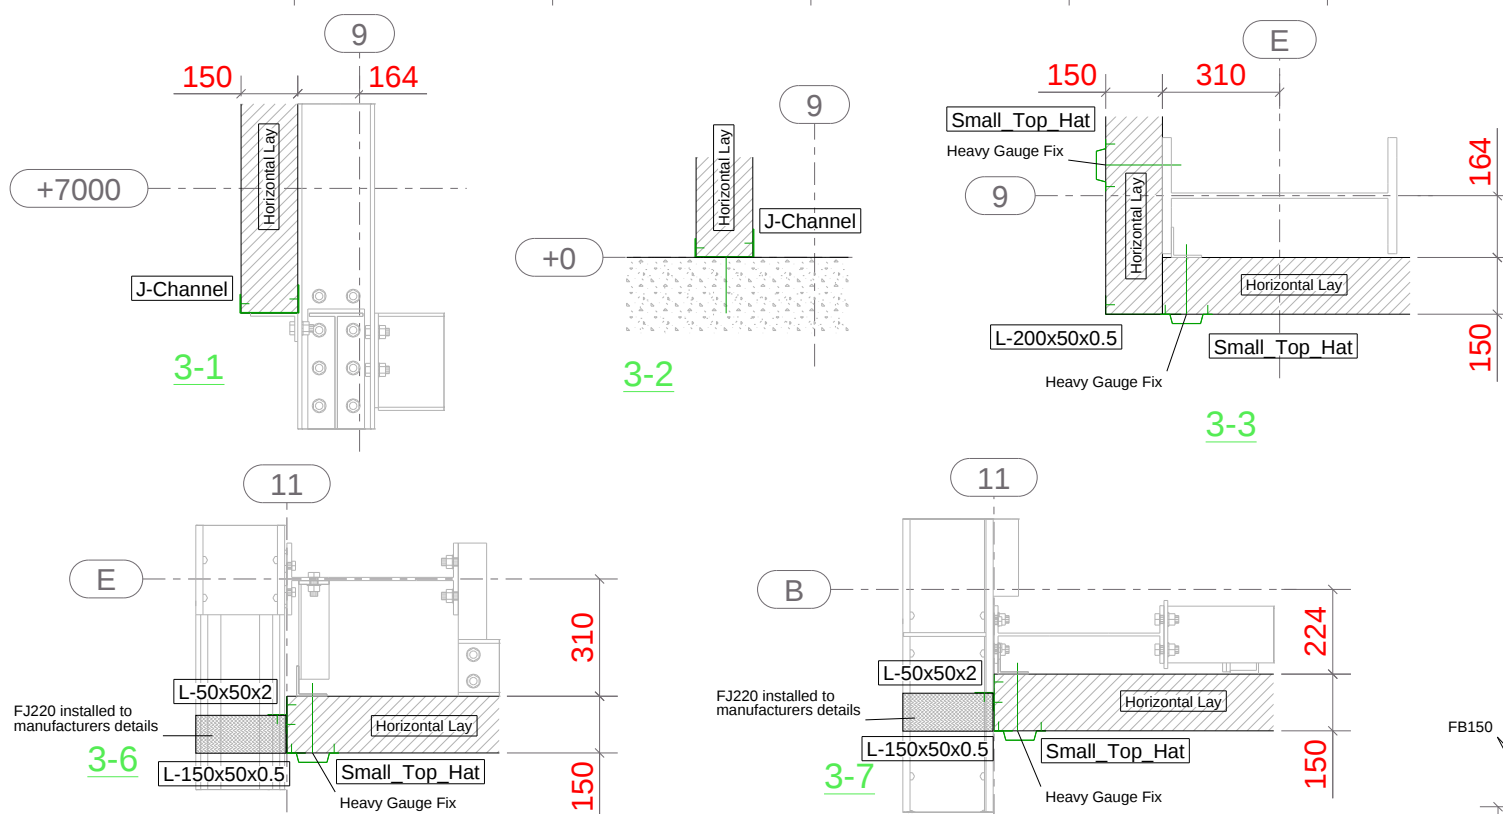

ZZ	As-built	26.04.2024
P05	3-8 & 3-11	30.01.2024
P04	Comments 12/1/24	16.01.2024
P03	Comments 6/12/23	10.01.2024
P02	Added connection details	28.11.2023
P01	Prelim Issue	27.11.2023
C02	Aligned Panels	08.03.2024
C01	Construction	16.02.2024
REV MARK	REVISION DESCRIPTION	REVISION DATE

Drawing Status :
AS-BUILT