


P23012 Wingates Plot 3

Drawing Register: Schindler


*Please note: All drawings listed below are hyperlinked to the drawings listed.
Please click on the drawing title to go directly to the drawing of your choice.*

Works Completed: Lifts


Drawing No.	Drawing Title	Rev
11781718	11781718	AB

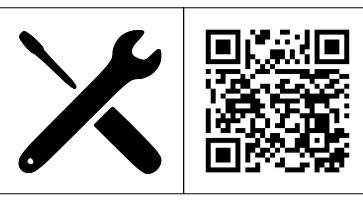


Well Head 1:20

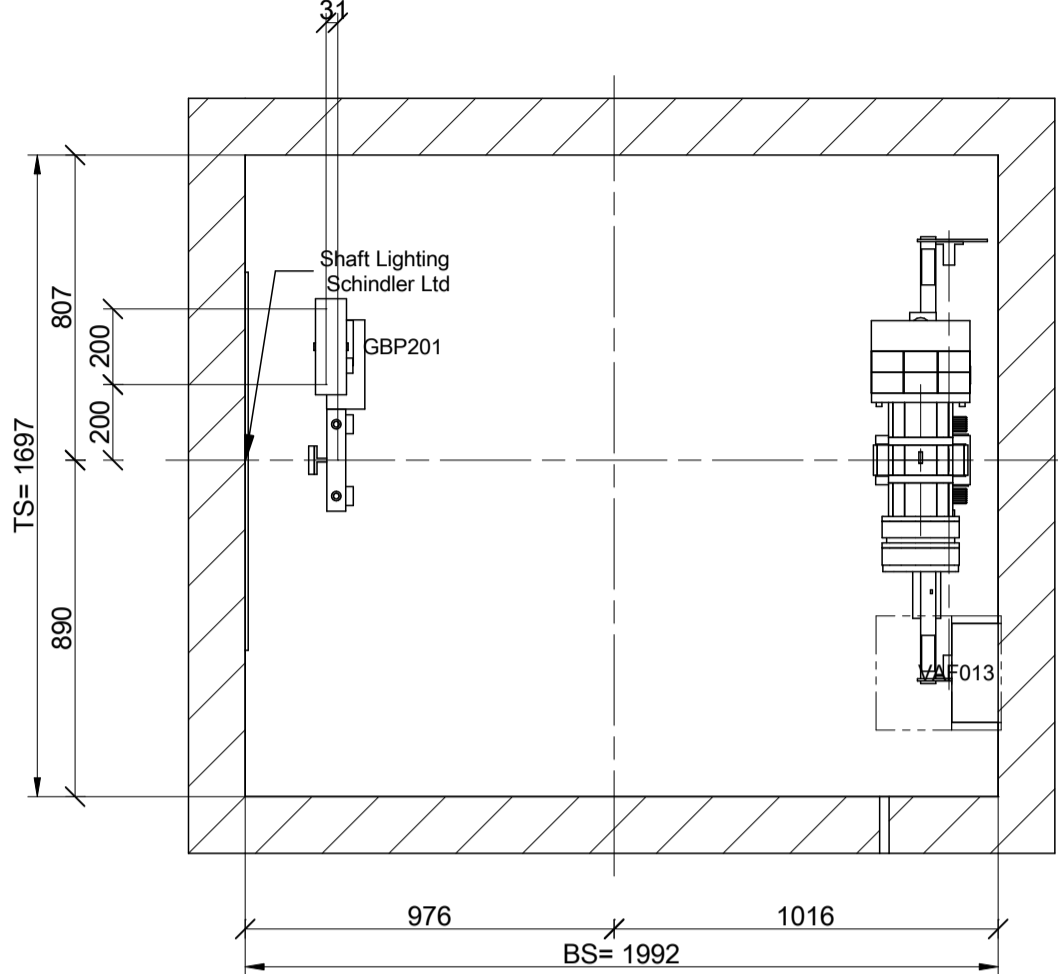


Access side 1 1:50

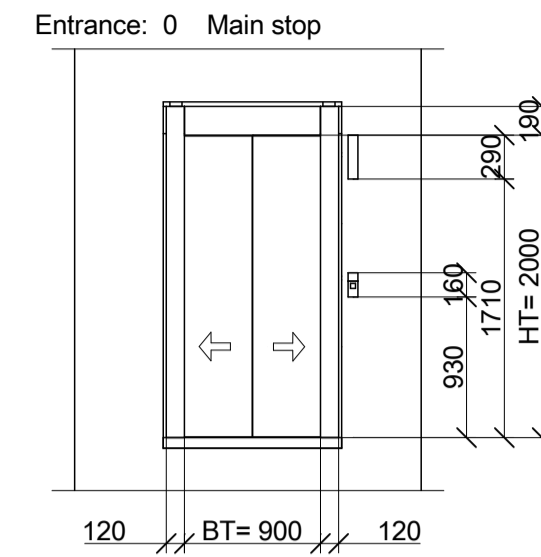



Wellhead and Wellpit 1:75

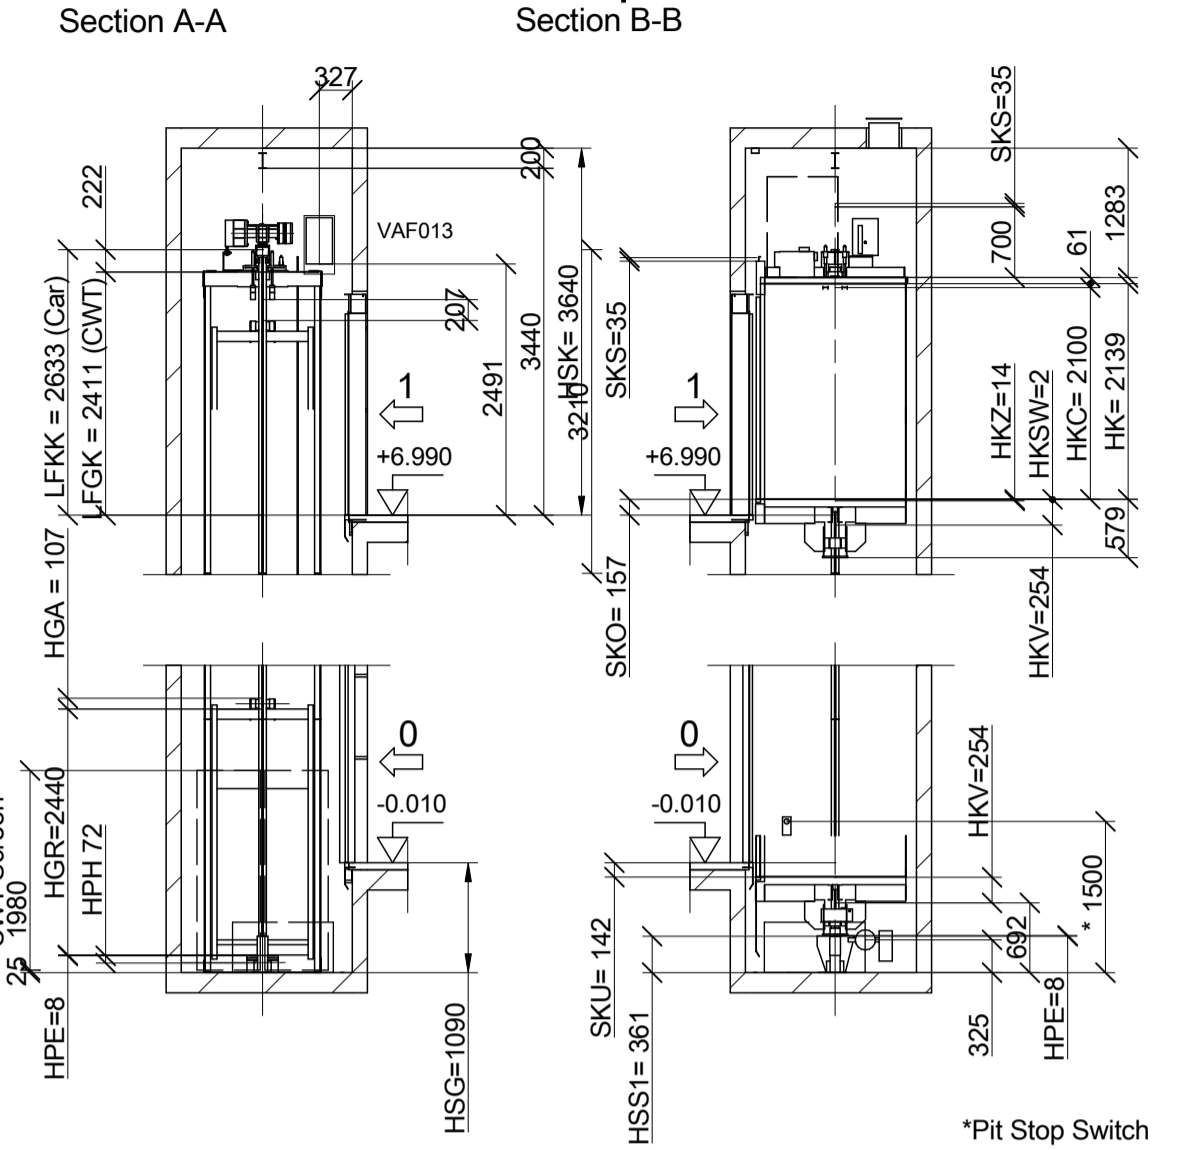

Door Detail 1:20

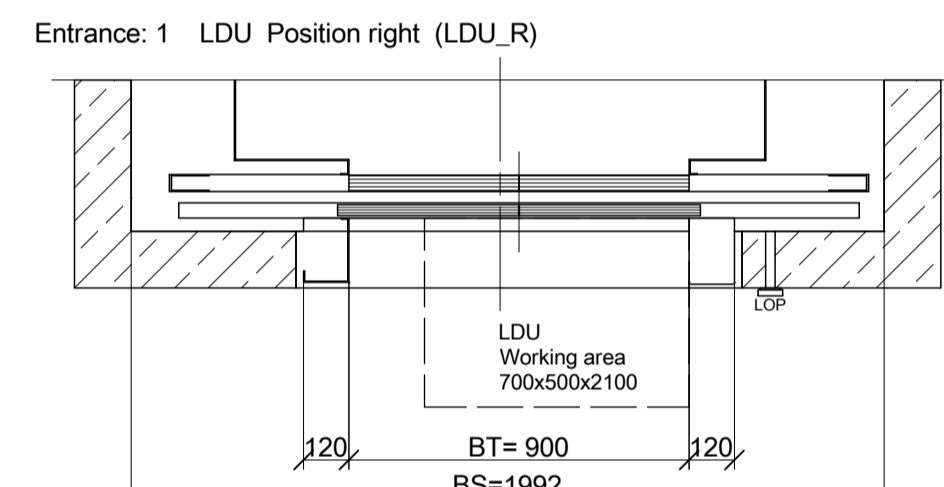

Access side 1 1:50

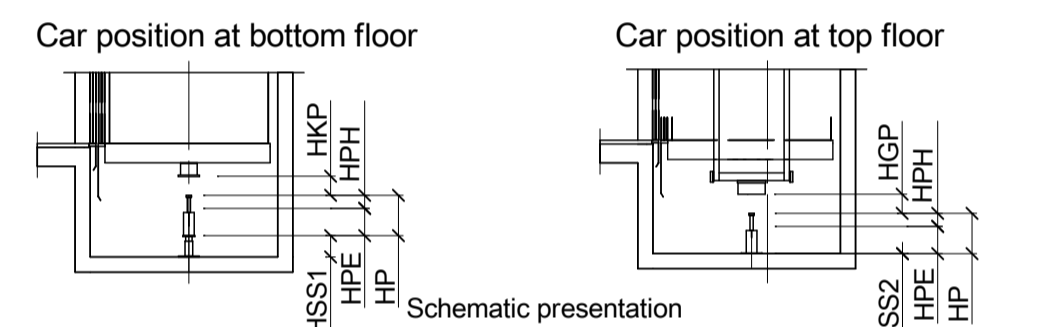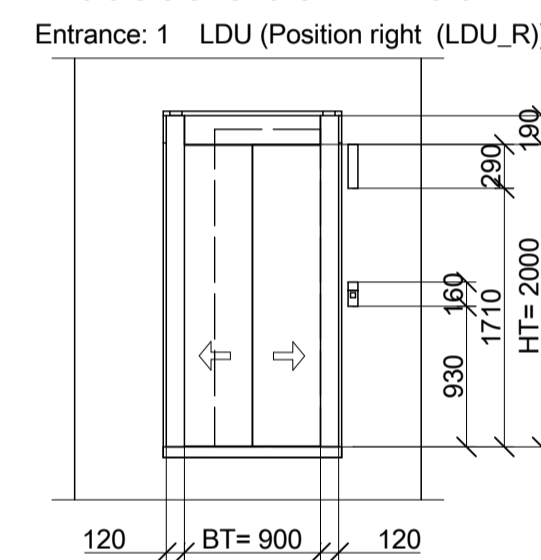


	Car buffer	Counterweight buffer
PS_D2		
(HP) [mm]	80	80
HPH/HPHL [mm]	72 / 72	72 / 72
HKP/HGP [mm]	70 -5/0	85 -20/0
HSS1/2 [mm]	371	167
HPE [mm]	8	8
Quantity	2	2


Refuge spaces		
Position and dimension	Label	
On car ceiling 500x700x1000		⚠ Crouching
In hoistway pit 700x1000x500		⚠ Laying

Acc code: Electric lighting (with switch) shall provide at least 200 lux at working areas.
The internal lamp in the cabinet assures the required 200 lux at the working area in front of control box/LDU


Section A-A 1:50

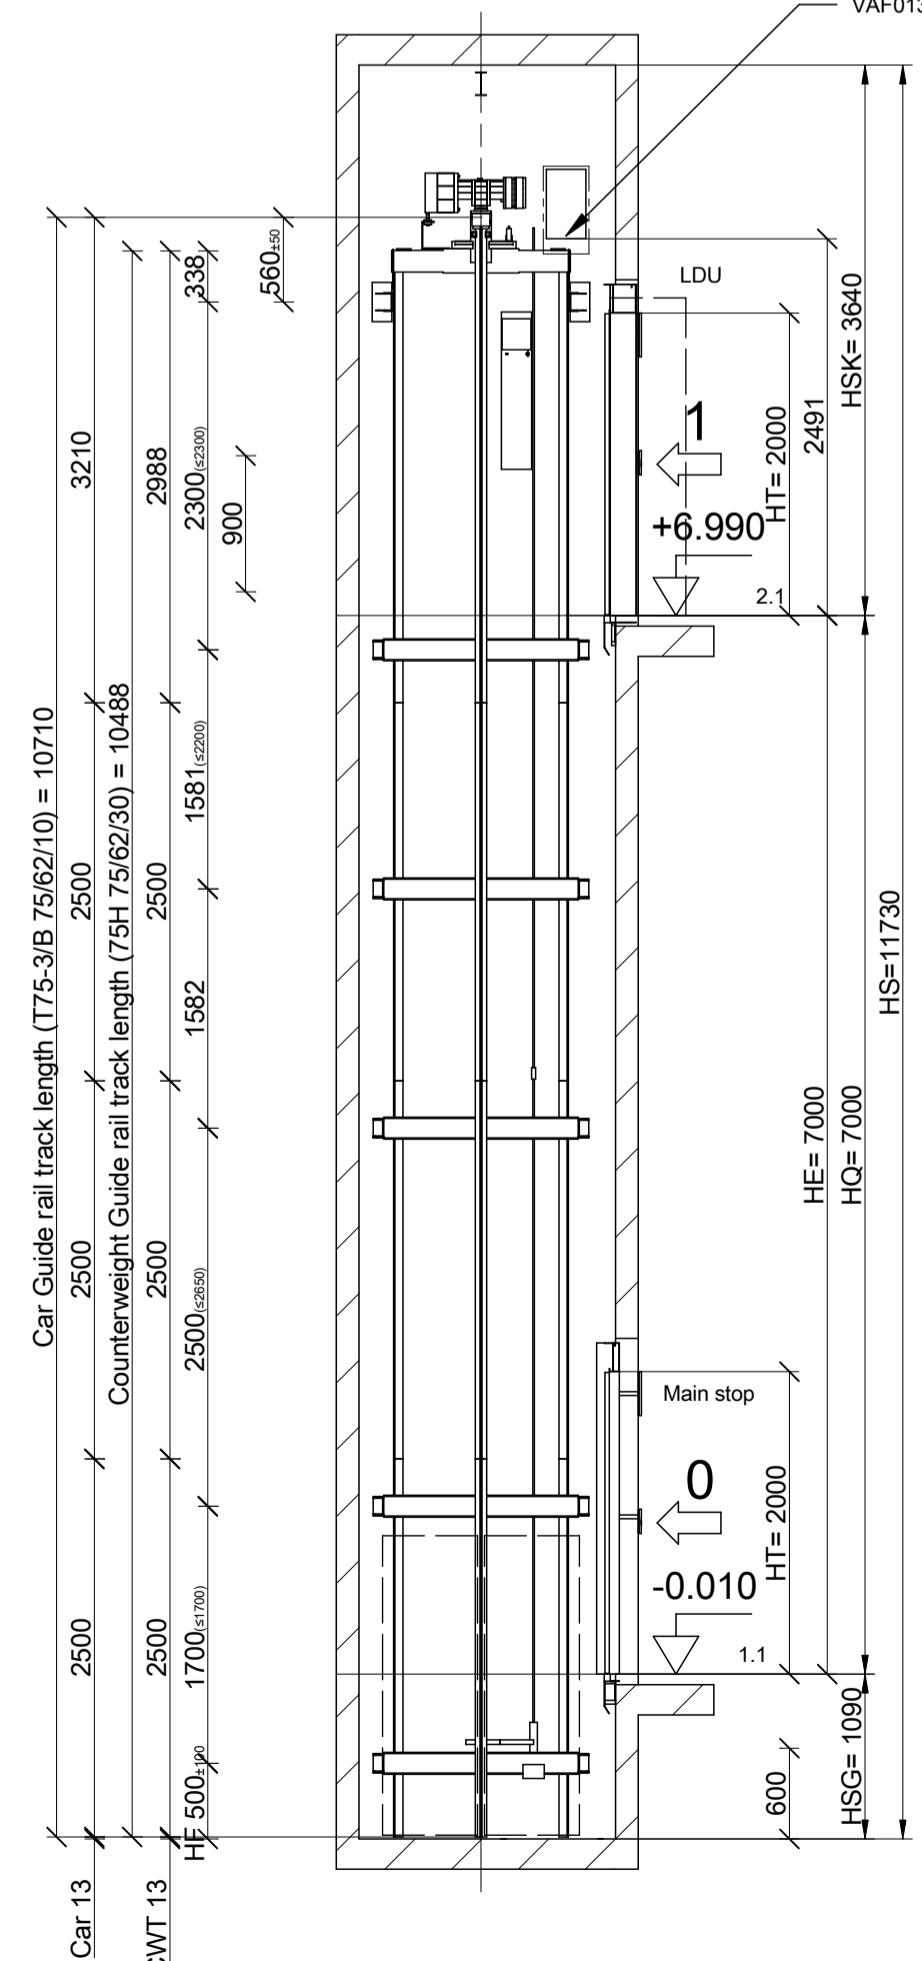

Section B-B 1:50

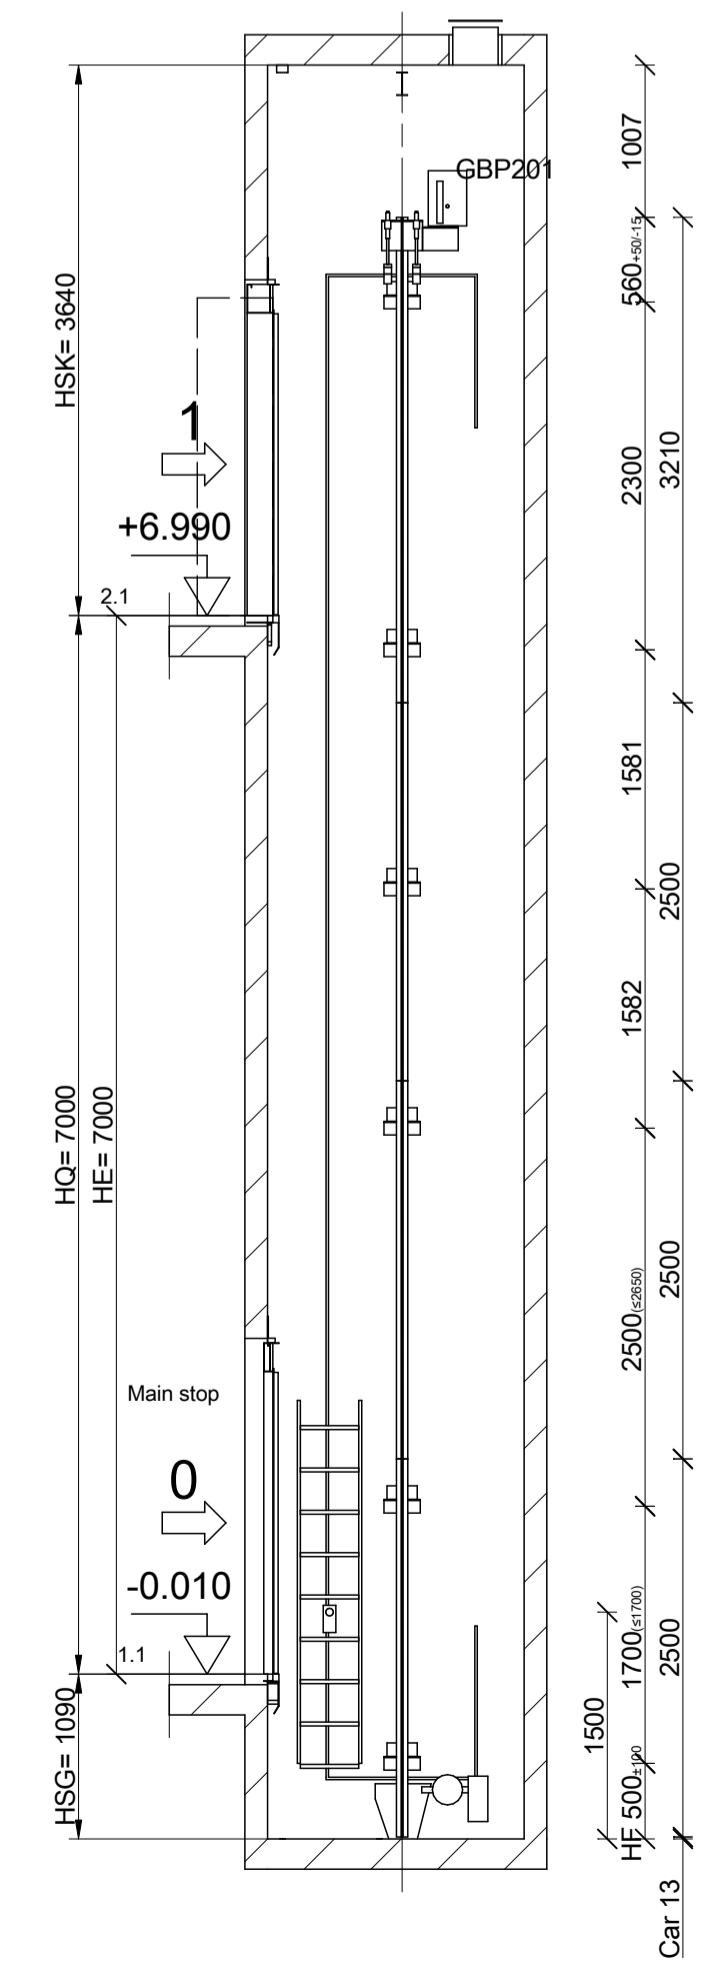


Well 1:20

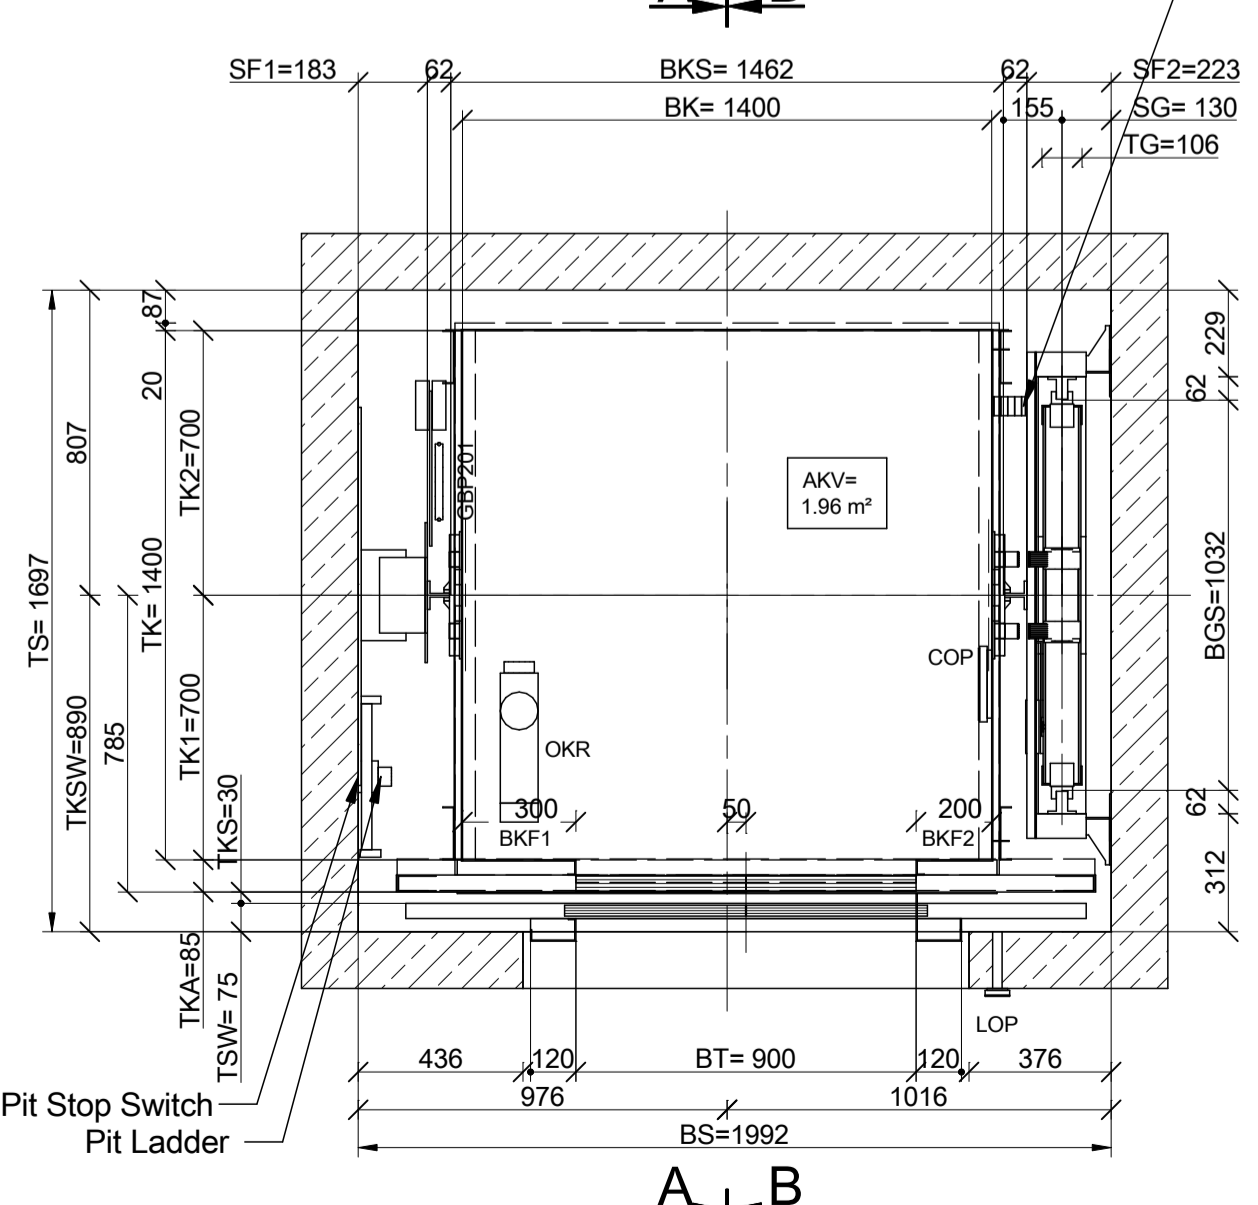

Bracket Selection

HFmax 2650 [mm]	Car side	Counterweight side
Complete hoistway	12 x Z-AL4	1 x L-B L 106 2 *
Type of clip for guide rail fixation	SL3 (SHORT)	SL75

Overview of refuge space situation 1:50

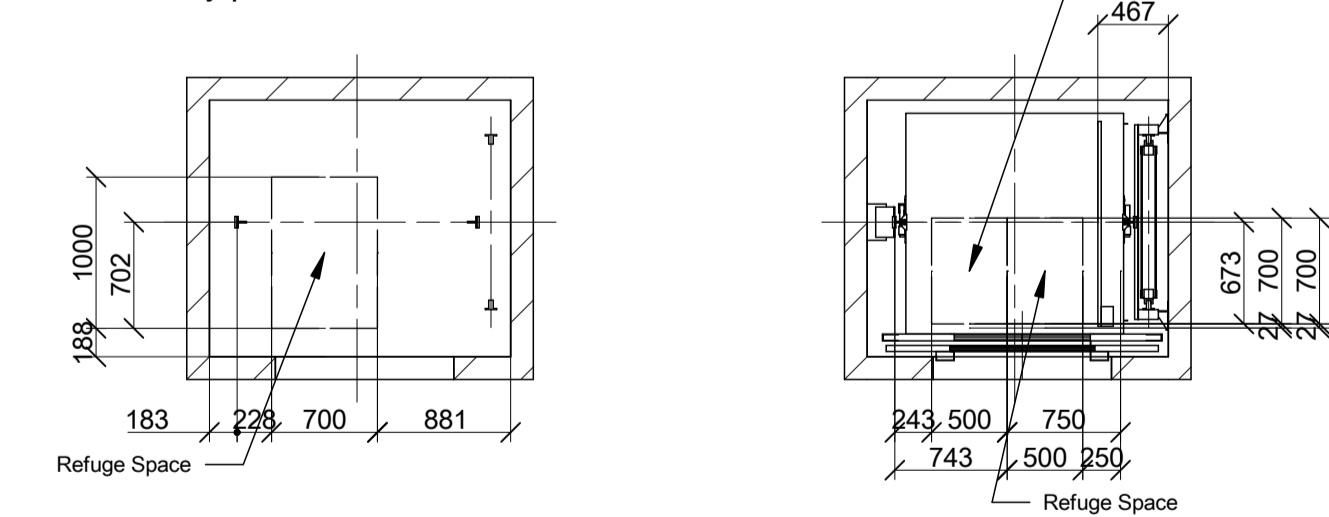

Revision	Modification	Modified by	Reviewed by	Date
01	Automatic Generation with SAP data CP 341 (20231108)	SMITHHA		12/02/2024
02	AS BUILT	HACKNEGE		26/06/2024

Installation Plan views

Product Line: Schindler 3000

Building: Unit 3 - Wingates, Bolton
Sales Unit Name: Lift 1
Address: Wingates Unit 3 - BLS 3LY Bolton
Client: Winvic Construction Limited - 19 Tenter Road - NN3 6PZ Northampton


Further inquiries concerning this plan on Tel: _____

Drawn	SMITHHA	12/02/2024	Page
Released		2024.02.12	2/6


Comm. No. UKC0011781718
Plan No. D 11781718.101 02

This design and information is our intellectual property. It must neither be copied in any way nor used for manufacturing nor communicated to third parties without our written consent.
Diese Darstellung ist unser geistiges Eigentum. Sie darf ohne unsere schriftliche Zustimmung weder irgendwie kopiert noch zur Anfertigung des Werkes gebraucht oder Dritten sonst bekanntgegeben werden.
Cet ouvrage est notre propriété intellectuelle. Sans notre autorisation écrite, il ne peut être ni copié d'une manière quelconque ni être utilisé pour la fabrication, ni non plus être communiqué à des tiers.

Laser plumb / Installation Information: 1:25

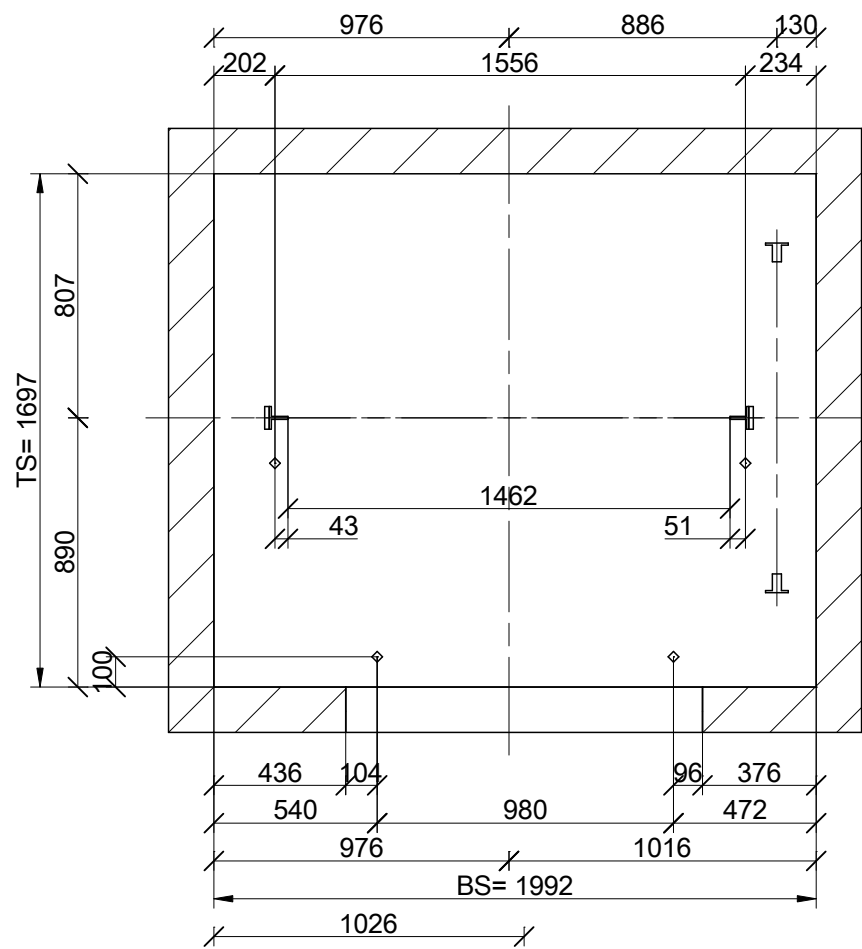

Detail view for car rail lines setting

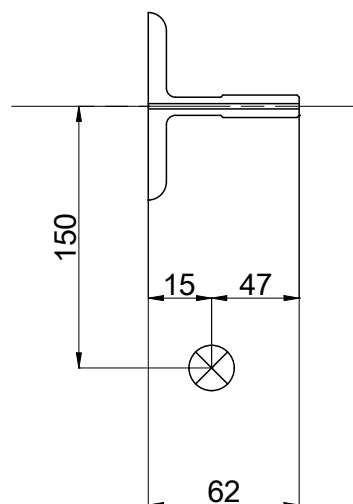

Revision	Modification	Modified by	Reviewed by	Date
01	Automatic Generation with SAP data CP 341 (20231108)	SMITHHA		12/02/2024
02	AS BUILT	HACKNEGE		26/06/2024

Installation **Laser plumb / Installation Information** Product Line: Schindler 3000

Building **Unit 3 - Wingates, Bolton**
 Sales Unit Name **Lift 1**
 Address **Wingates Unit 3 - BL5 3LY Bolton**
 Client **Winvic Construction Limited - 19 Tenter Road - NN3 6PZ Northampton**

Schindler Ltd
 Dashwood Lang Road
 KT15 2HJ Addlestone

Contact:

Drawn	SMITHHA	12/02/2024	Page
Released		2024.02.12	3/6
Comm. No.	UKC0011781718		
Plan No.	D 11781718.GEN		

Cet ouvrage est notre propriété intellectuelle. Sans notre autorisation écrite, il ne peut être ni copié d'une manière quelconque, ni être utilisé pour la fabrication, ni non plus être communiqué à des tiers.

Diese Darstellung ist unser geistiges Eigentum. Sie darf ohne unsere schriftliche Zustimmung weder irgendwie kopiert noch zur Anfertigung des Werkes gebraucht oder Dritten personen bekanntgegeben werden.

This presentation is our intellectual property. Without our written consent, it shall neither be copied in any manner, nor used for manufacturing, nor communicate to third parties.

Cet ouvrage est notre propriété intellectuelle. Sans notre autorisation écrite, il ne peut être ni copié d'une manière quelconque ni être utilisé pour la fabrication, ni non plus être communiqué à des tiers.

Diese Darstellung ist unser geistiges Eigentum. Sie darf ohne unsere schriftliche Zustimmung weder irgendwie kopiert noch zur Anfertigung des Werkes getraucht oder Dritten bekanntgegeben werden.

This presentation is our intellectual property. Without our written consent, it shall neither be copied in any manner, nor used for manufacturing, nor communicate to third parties.

MAIN DATA		CP341
Sales Unit Name		OFFICE LIFT
Elevator system / Technical cluster		ES1 / 1.3.1
Elevator category		Person Elevator
Rated load [kg]	GQ	800
Number of passengers	ZQG	10
Rated speed of car [m/s]	VKN	1.00
Travel height [m]	HQ	7.00
Roping	KZU	2
Number of stops	ZE	2
Number of LD front per elevator	ZEZ1	2
Number of LD rear per elevator	ZEZ2	0
Control type		Scalable Control
Control system		KS
Number of elevators in group	ZAG	1
Regulation code		EN 81-20:2020
Handicapped code		EN_81-70_2021
Building tolerance		-25/+25mm
Vandal resistance category		No vandalism
Fire code		No
EN 81-73		Yes
Fire emergency service / Activation		BR1 KBF
Seismic code / Seismic category		No
Car width x Car depth	BKxTK	1400x1400
Clear car width	BK_Clear	1400

DRIVE TRAIN			
Machine type		PMB135-A11-608	PMN 5.70 kW
Traction sheave diameter [mm]	DD	87	PME 5.09 kW
Balancing of load [%]	KG	50	
Number of suspension media	ZZ	2	
Car Total length of 1 susp.media [m]	LZ	24	
Width of suspension media [mm]	BZ	40	
Inverter type	VF	VAF013_480	
Type of STM		STM-PV40	
Material of STM		PU	

CAR DATA		
Car type		CA PK 44
Car sling type		--
Car door type		DO VAR 15
Car guideshoes type		I10
Car safety gear type		SA GED 10
Weight of car [kg]	GK	592
Masses acting upon car safety gear [kg]	GKU	1393
Car weight during installation [kg]	GK_INEX	283

LANDING DOOR DATA	
Landing door type	DO WIV EU (Wittur Evo EU)
Fire rating of landing door	EN_81-58_E120
	all
Fire rating of landing door	-
	-
Fire rating of landing door	-
	-
Landing Door Finish	SS441_BRUS
	all
Landing Door Finish	-
	-
Landing Door Finish	-
	-

MECHANICAL EQUIPMENT		
Compensating media type		-
Compensation tension device		Not ordered
Weight of one comp. media per m [kg]	GUM1	-
Car Ov. governor rope diameter [mm]		6
Car Ov. governor rope type		Seale 6x19S SFC 1770 B sZ
Car guide rail type		T75-3/B
Counterweight guide rail type		H75-1
Car buffer type		P+S type D2
CWT buffer type		P+S type D2
Car overspeed governor type		GBP201
Car Total length of Ov. Governor Rope [m]		23
Car tension device type		201CB
CWT overspeed governor type		Not ordered
CWT Total length of Ov. Gov. rope [m]	LCR	-
CWT tension device type		Not ordered

ELECTRICAL PARAMETERS		
Operating temperature range [°C]	T_Operation_Range	+5/+40
Humidity [%]	Humidity_Range_Electrical	max 60% at 40°C or 85% at 25°C
Altitude above sea level [m]	HAM	2000
Cable routing type when MMR/MR	MR_Cable_Routing	Not relevant
Number of starts per hour max.	ZKH_max	180
Heat generation in hoistway head [kW]	POW_S	0.44
Heat generation at LDU landing [kW]	POW_LDU	0.16
Main power supply acc. IEC 60364-1	Supply_Power_Net_Type	TN-S
Mains volt. supplied to bldg. by utility service [V]	UNS	400
I_max of overcurrent prot. dev. building char.gG[A]	SIH_Size	Not relevant
Input current of transformer TA [A]	ITA1	0
I_max of overcurrent prot. dev. TA output char.gG[A]	SIH1_Size	Not relevant
Neutral wire	Neutral_Wire	Yes
Rated mains [V] / Mains voltage tolerance [%]	UN / UN_Tol_Range	400 / -15/+10
Mains voltage asymmetry range [%]	UN_Phase_Asymmetry_Range	-5/+5
Mains current during constant speed [A]	INN	10.95
Mains current during acceleration ³⁾ [A]	INA	12.43
Mains frequency [Hz] / Tolerance [%]	FN / FN_Tol_Range	50 / -5/+5
Main switch	JH_Variant	MCB C16A
Cable cross section at JH min / max [mm²]	ANN_JH_min/_max	1 / 25
Failure current maximum [mA]	I_Delta_N_max	300
Short circuit current rating max. [kA]	SCCR_max	6
Max total harmonic distortion mains current [%]	THDI_max	37
Surge protection device	SPD_Opt	No
Surge protection voltage max [kV]	USP_Max	2.00
RCD fail. curr. switch on bldg. side mandatory ¹⁾	JFIH_Opt	No
Maximum regenerative power ²⁾ [W]	PNAG	2409
Mains line impedance max [mOhm]	ZFN_max	300
Mains distortion Cos Phi / Power factor minimum	Cos_Phi_JH / PS_Ratio_min	0.99 / 0.92
Mains active pow at JH const speed/end accel [kW]	PNN / PNA	6.9 / 7.8
Mains apparent pow. const. speed / end accel. [kVA]	SNN / SNA	7.3 / 8.3
Mains voltage lighting [V] / Tolerance [%]	UNL / UNL_Tol_Range	230 / -15/+10
Lighting current ³⁾ [A]	INL	10
Main switch lighting	JHL_Type	RCBO C10A 30mA Type A
Cable cross section at JHL min / max [mm²]	ANN_JHL_min/_max	1 / 16
Main switch lighting hoistway	SIBS_Type	RCBO C10A 30mA Type A
Hoistway lighting current max ³⁾ [A]	I_SIBS_max	10.00
Hoistway lighting delivery	Hoistway_Lighting_Delivery	Yes
Cable cross section for SIBS min / max [mm²]	ANN_SIBS_min/_max	1.00 / 16.00
PORT main switch type	SIPT_Type	
PORT current at SIPT [A]	I_SIPT	
Automatic evacuation system (Attention: power!)	AES_Opt	No
Max. number of automatic evacuation trips in a row	Z_Evac	0

COUNTERWEIGHT DATA		
CWT type		GG41-1002-106-B
CWT guideshoes type		I7
CWT safety gear type		Not ordered
Weight of CWT [kg]	GG_Theoric	992
Masses acting upon CWT safety gear[kg]	GGU	--

¹⁾ If RCD in front of JH is installed: use rated current >= INN, tripping current >= I_Delta_N_max, Type B (all current sensitive) with a short time delay
²⁾ The building has to consume this recuperated energy by itself in case of emergency power supply of the mains power (NS2+)
³⁾ The cross-section of the wiring feeding the elevator power shall be sized for the voltage drop at 3% of the nominal installation voltage

AKV=	Car area
BS=	width shaft
BT=	width door
BK=	width car
BKS=	width car guide
BGS=	width cwt guide
BG=	width cwt
COP=	Car operation panel
GG=	Weight of cwt. GG (kg)
GK=	Weight of Car GK (kg)
GKU=	Masses acting upon CWT safety gear[kg]
HT=	height door
HE=	height floor
HQ=	height travel
HS=	height shaft
HSG=	height shaft pit
HSK=	height shaft headroom
HF=	Distances between guide rail fastening brackets
HK=	Car height
HKC=	Inside car height
HKZ=	Height car flooring
HGP=	Distance from counterweight to buffer
HKP=	Distance from buffer plate on car to buffer or plinth, with car at lowest terminal
HP=	Height of buffers, fully extended
HPH=	Rounded up total of buffer stroke and rubber stroke:
HSS1=	Height of plinth underneath car
HSS2=	Height of plinth underneath counterweight
JH=	Main switch
JH1=	Second main switch
LDU=	Control cabinet (LDU)
LFGK=	Length of cwt rail end from top floor
LFKK=	Length of car rail end from top floor
LOP=	Landing operation panel
SG=	guide cwt bracket
SF=	guide car bracket
SKU=	lift overtravel (bottom)
SKO=	lift overtravel (top)
SKS=	Jump distance of car
TS=	depth shaft
TK=	depth car
TG=	depth cwt
TKF=	Distance between edge of car sill and guide rail axis
TSW=	Distance from hoistway front wall to landing door sill
TKSW=	Distance from hoistway front wall to center line of car guides




Subsystem of Unintended Car Movement Protection	
Detection Means	-
Certificate number	-
Stopping Means	Machine Brake 2X125
Certificate number	NL19-400-1002-051-02


Revision	Modification	Modified by	Reviewed by	Date
01	Automatic Generation with SAP data CP 341 (20231108)	SMITHHA		12/02/2024
02	AS BUILT	HACKNEGE		26/06/2024

General Information:		Product Line:	
		Schindler 3000	
Building	Unit 3 - Wingates, Bolton		
Sales Unit Name	Lift 1		
Address	Wingates Unit 3 - BL5 3LY Bolton		
Client	Winvic Construction Limited - 19 Tenter Road - NN3 6PZ Northampton		
		Further inquiries concerning this plan on	
		Tel:	
Drawn	SMITHHA	12/02/2024	Page
Released		2024.02.12	4/6
Comm. No.	UKC0011781718		
Plan No.	D 11781718.GEN 02		


Left wall 1:20

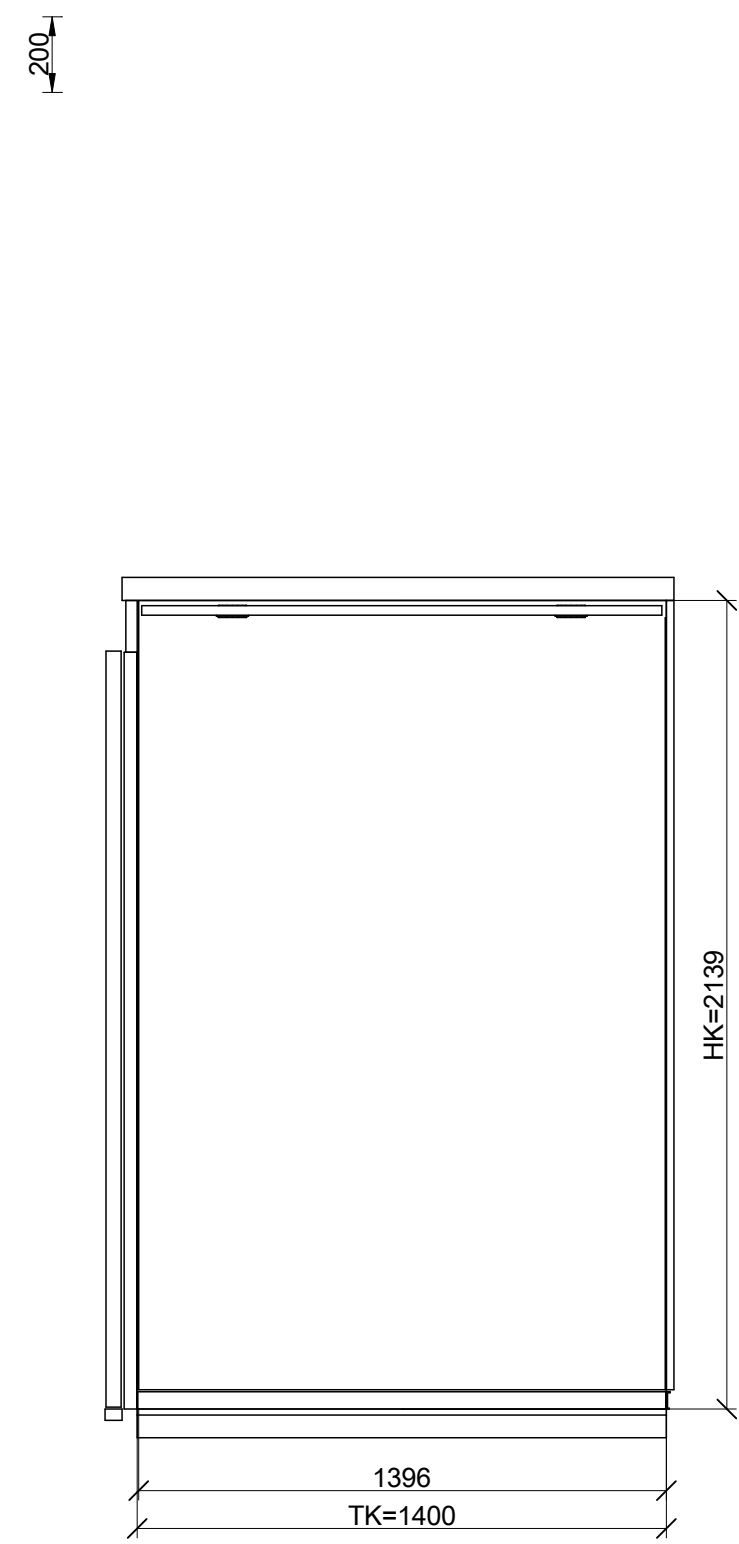


Rear wall 1:20

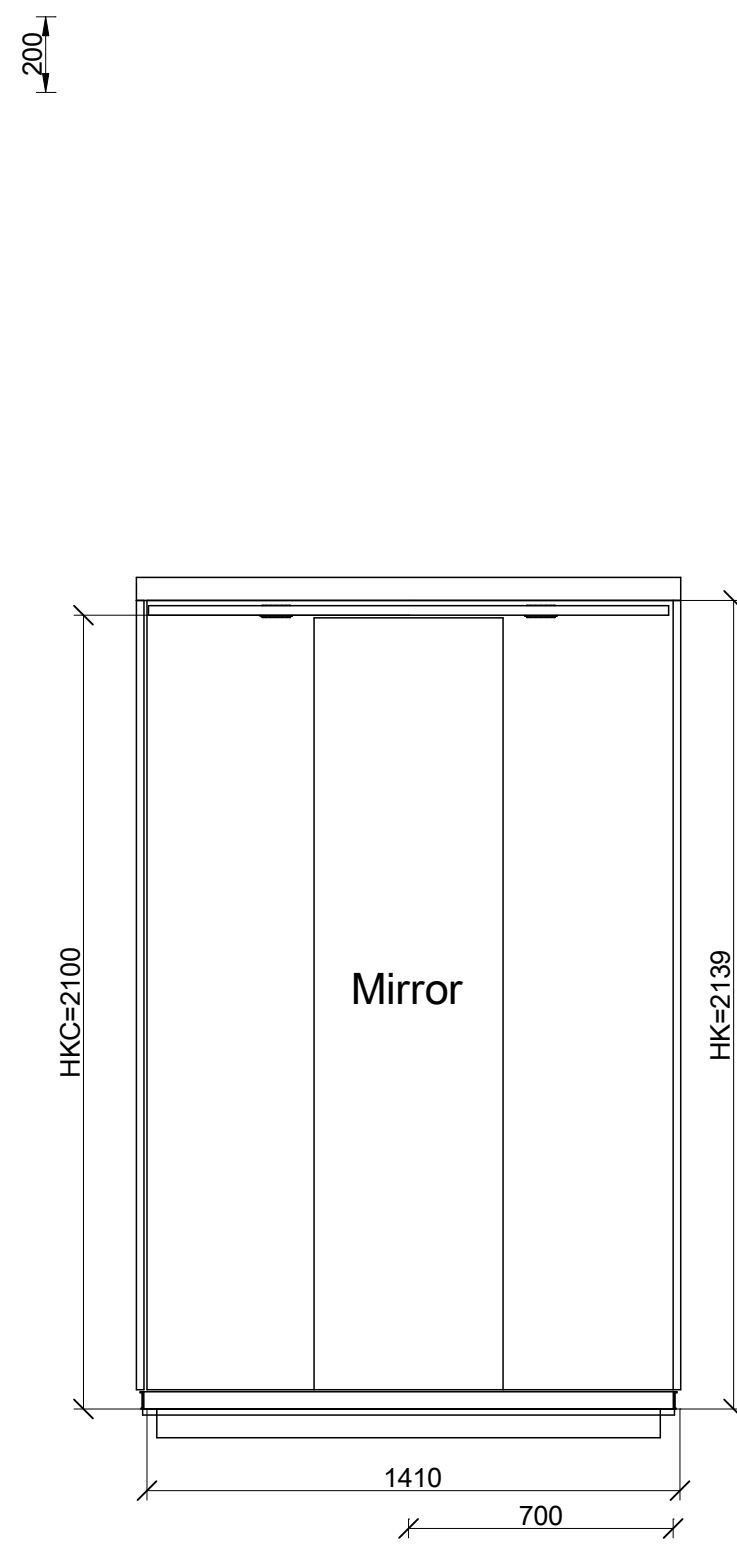

Right wall 1:20

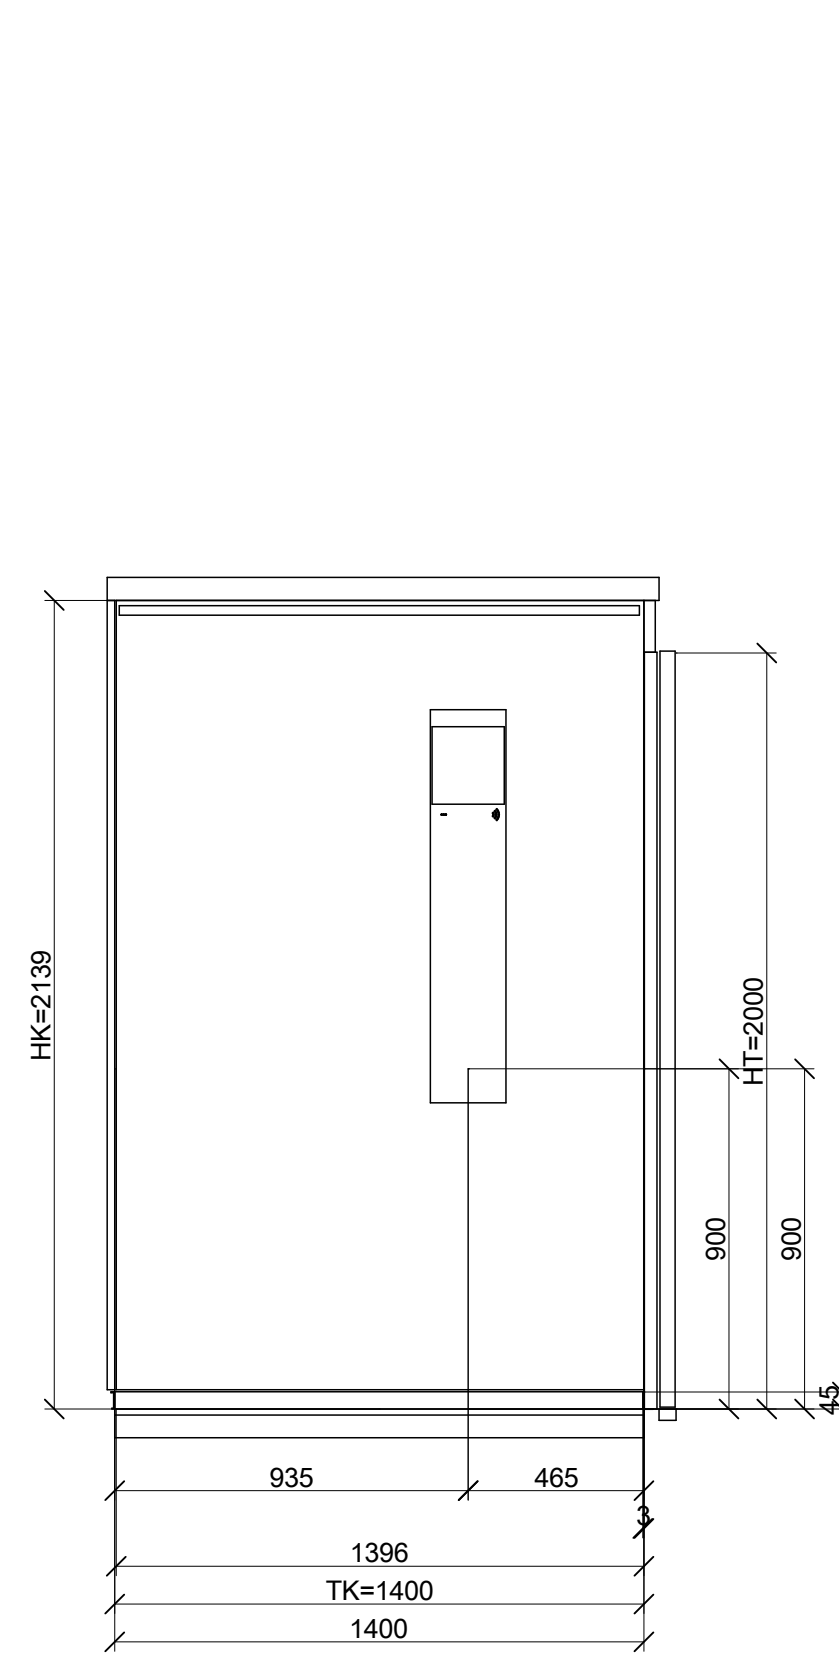

Front wall 1:20

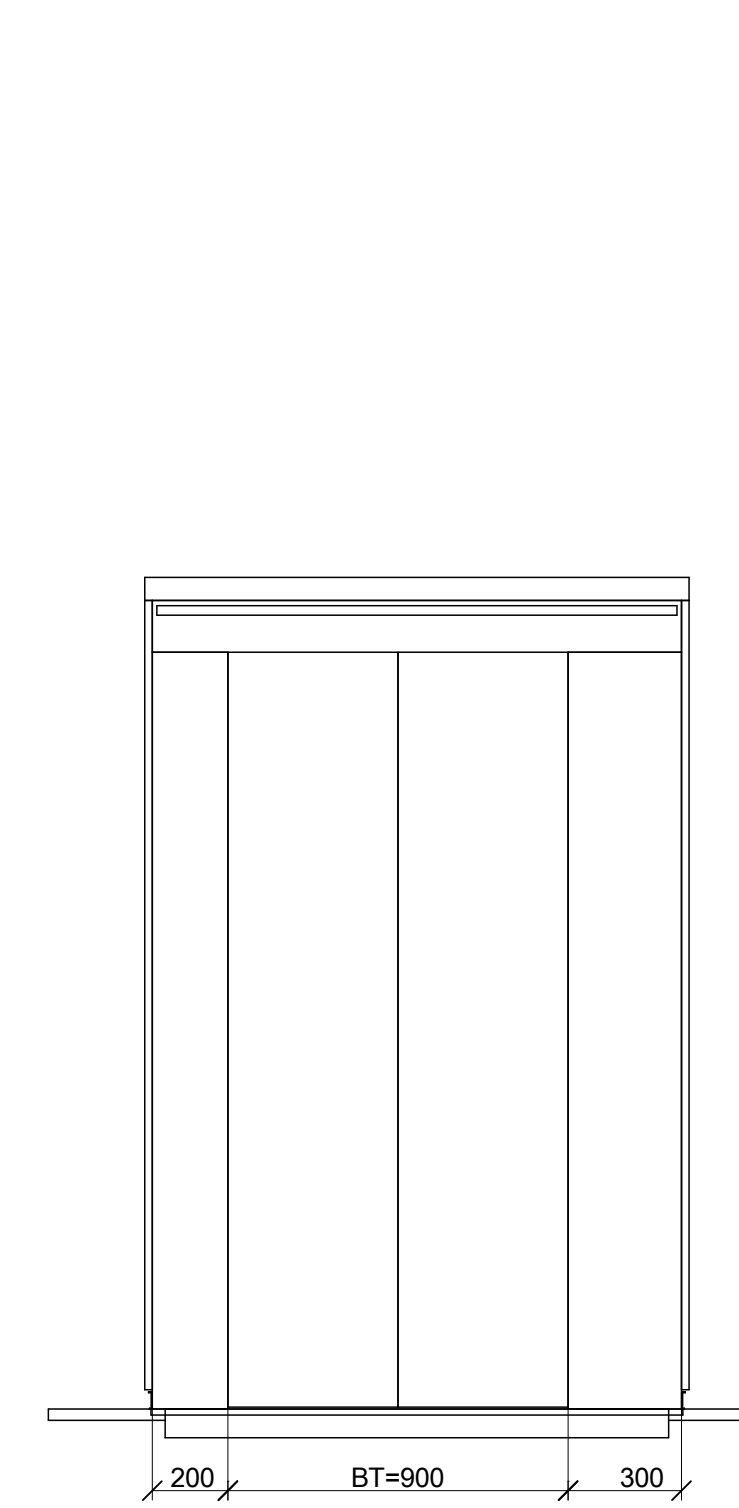


CAR DECORATION	
Car front finish	St steel AISI441 brushed
Door finish	St steel AISI441 brushed
Side walls material	Stainless st claddd honeycomb
Side walls finish	St steel cladd AISI441 brushed
Rear wall material	Stainless st claddd honeycomb
Rear wall finish	St steel claddd AISI441 brushed
Car skirting finish	Aluminum anodized gray
Car skirting alignment	Flush
Car skirting shape	Straight
Floor material	Bare steel
Floor finish	Bare steel
Car decoration line	Times Sq
Ceiling type	Round spot
Power of all car lamps	45.00 W
Ceiling decoration	St steel AISI441 brushed
Mirror left	Not ordered
Mirror rear	Full height par. width, center
Mirror right	Not ordered
Rear wall glass type	Not ordered
Side wall glass type	Not ordered
Handrail finish	St steel AISI304 brushed
Handrail left	No
Handrail right	Parametric
Handrail rear	No
Bumper Rails Design	-
Bumper Rails Type	-
Weight of car decoration (GKD)	-
Weight of custom ceiling	-
Weight of custom floor	50
Weight of additional custom decoration	-
Weight of custom decoration	50
Fix apron	787 mm
Emergency Exit	Not ordered

CAR OPERATION PANEL CONFIGURATION	
COP type	FI GS 100
Mounting	Surface
2nd COP version	Not ordered



BT= width door
 BK= width car
 COP= Car operation panel
 HT= height door
 HK= Car height
 HKC= Inside car height
 HKZ= Height car flooring
 TK= depth car

Handrail position and handrail length should be calculated according to the R&D documentation

Ceiling 1:20

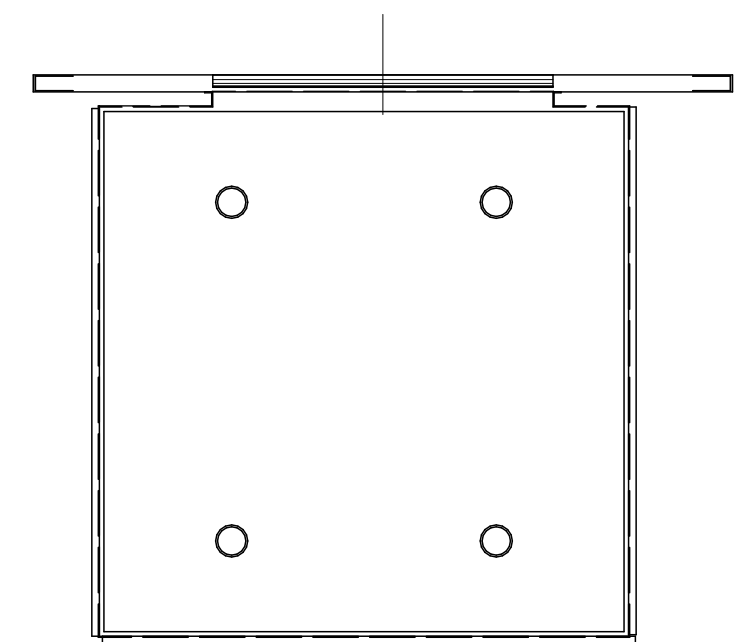

Plan view car 1:20

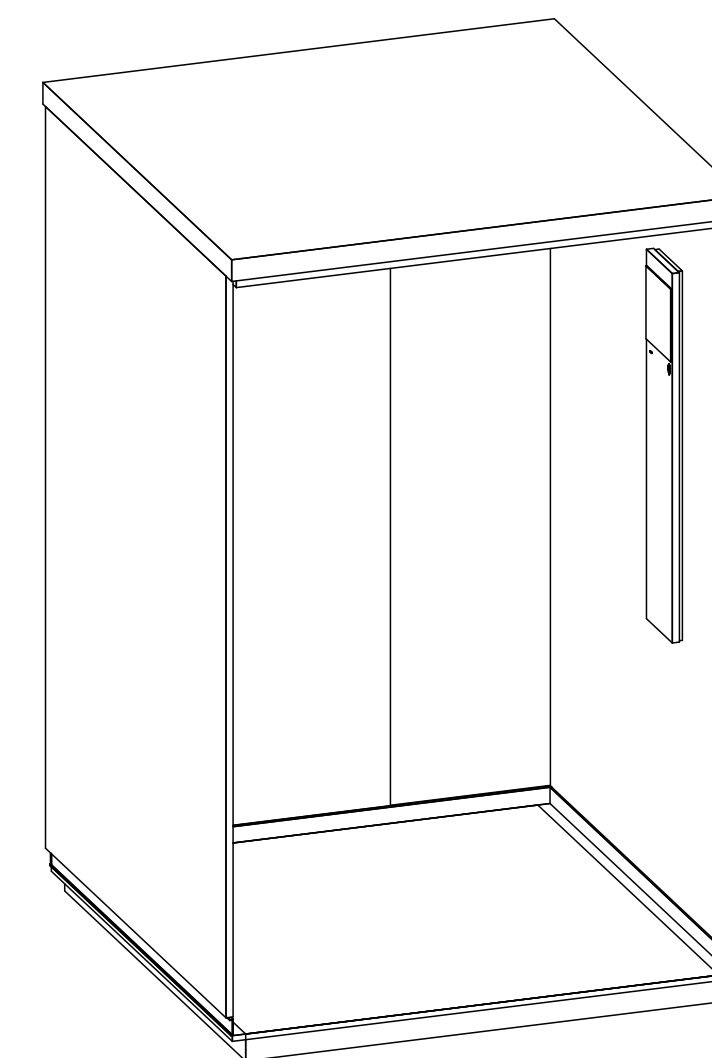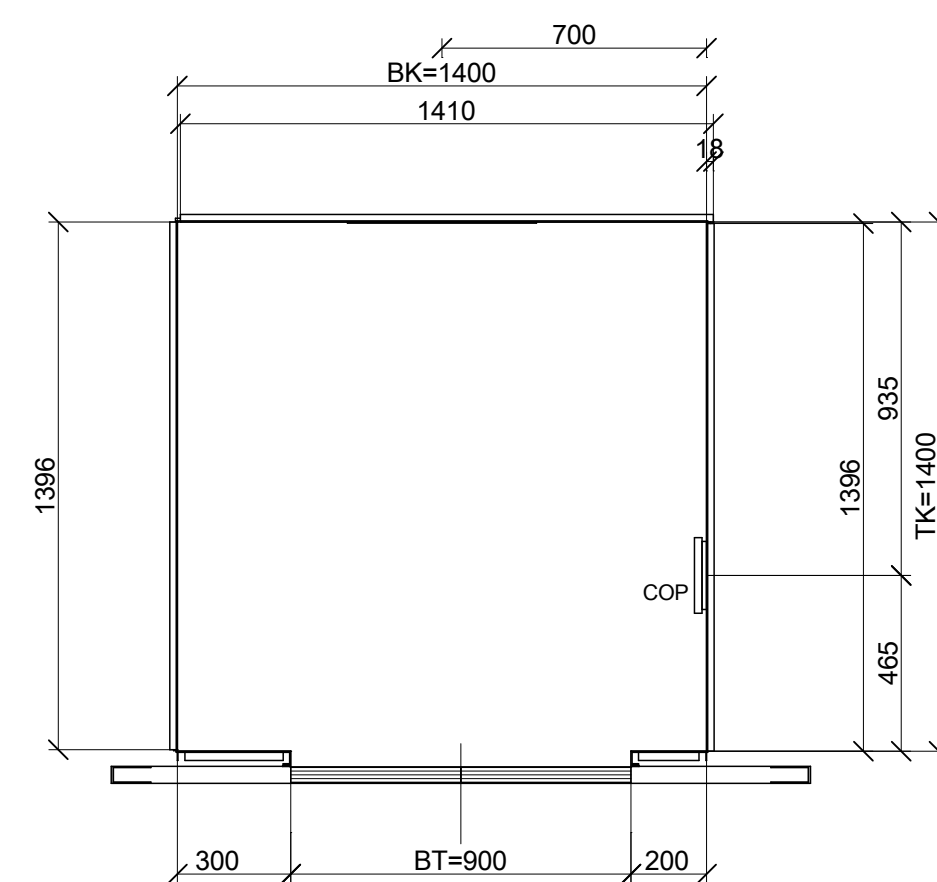

Approval - Mark

accord

accord after modification

Date _____ Name _____

Car Layout Product Line: **Schindler 3000**

Building: **Unit 3 - Wingates, Bolton**

Sales Unit Name: **Lift 1**

Address: **Wingates Unit 3 - BL5 3LY Bolton**

Client: **Winvic Construction Limited - 19 Tenter Road - NN3 6PZ Northampton**


Further inquiries concerning this plan on

Drawn: **SMITHHA** Tel: **12/02/2024** Page: **6/6**

Released: **2024.02.12**

Comm. No. **UKC0011781718**

Plan No. **D 11781718.CAP 02**


 Schindler Ltd
 Dashwood Lang Road
 KT15 2HJ Addlestone
 Contact:

This design and information is our intellectual property. It must neither be copied in any way nor used for manufacturing nor communicated to third parties without our written consent.

Diese Darstellung ist unser geistiges Eigentum. Sie darf ohne unsere schriftliche Zustimmung weder reproduziert noch zur Anfertigung des Werkes gebraucht oder Dritten ohne unsere Genehmigung weitergegeben werden.

Cet ouvrage est notre propriété intellectuelle. Sans notre autorisation écrite, il ne peut être ni copié d'une manière quelconque, ni être utilisé pour la fabrication, ni non plus être communiqué à des tiers.